

KANSAS


FORM 51 5M BRIX

Butler County

Section 17 Township 25 Range 5E

Well No. #32 Robinson

Company Texas

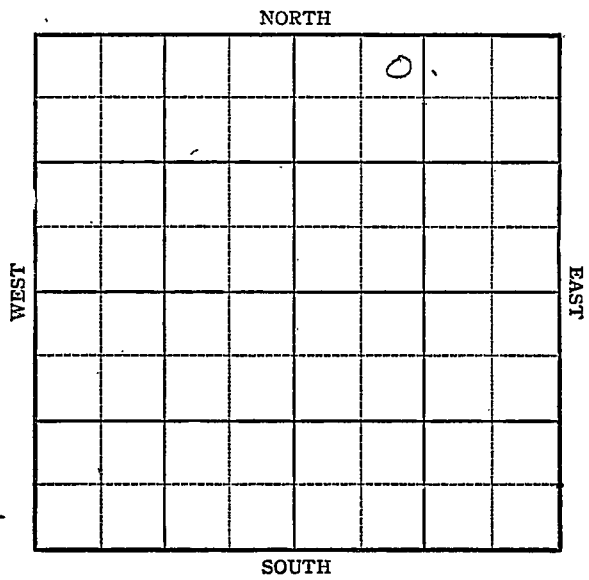

KANSAS

Butler County

Sec. 17 Twp. 25 R. 5E

Well No. #32 Robinson Farm

Texas Company


Misc.

330 Ft. from N. Line

_____ Ft. from S. Line

_____ Ft. from E. Line

990 Ft. from W. Line

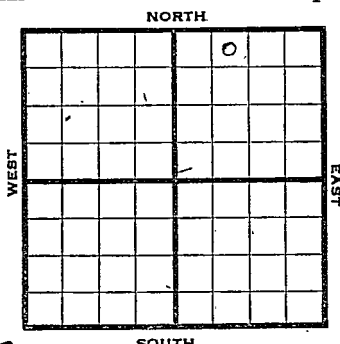

NE NW NE *Elev. 1362*

1944

R E P O R T

10/11 Loc:

10/18 "

10/25 "

11/1 "

11/8 "

11/16 "

11/24 Rig

11/29 "

12/6 15" @ 195.
Drlg. 660

12/14 12" @ 872' Drlg. 920'

12/21 10" @ 1668'
Drlg. 1730'

12/29 Viola 2438
TD 2440
7" @ 2440' RUST

1945

1/3 2438 washed swbViola
Drlg 2625

1/10 Arb 2675
TD 2750 SW

1/17 Arb 2675
TD 2750

ABANDONED

Pool Name Miscellaneous

Map No. 1 X **KANSAS** Sec. 17 Twp. 25 R. 5E

Well No. 32 Robinson

Texas Company

FIRST REPORT Contractor

NE NW NE

SECTION PLAT

330 Ft. from N. Line

_____ Ft. from S. Line

_____ Ft. from E. Line

990 Ft. from W. Line

			0

Butler County

RECORD

Location X

Rig up _____

Drilling and Remarks:

Cased _____ in., _____ ft.

Sand _____

Gas _____

Oil _____

Total Depth _____

PRODUCTION

1st 24 hrs. Nat. _____

1st 24 hrs. after shot _____

Gas _____ Cu. Ft.

Dry Hole _____

Abandoned _____

Date

OCT 11 1944 19

S. J. LEWIS Scout

KANSASMap No. _____ Sec. 17 Twp. 25 R. 5EWell No. 32 Robinson

_____ Texas _____ Company.

_____ **ABANDONED** _____ Contractor

NE NW NE

SECTION FLAT330 Ft. from N. Line

_____ Ft. from S. Line

_____ Ft. from E. Line

990 Ft. from W. Line

			o

Butler

RECORD

Location _____

Cased _____ in., _____ ft.

Rig up _____

Sand _____

Drilling and Remarks:

Gas _____

Cu 2675

Oil _____

Total Depth 2750**PRODUCTION**

1st 24 hrs. Nat. _____

1st 24 hrs. after shot _____

Gas _____ Cu. Ft.

Dry Hole _____

Abandoned _____

Date

JAN 17 1945

19

S. J. LEWIS Scout