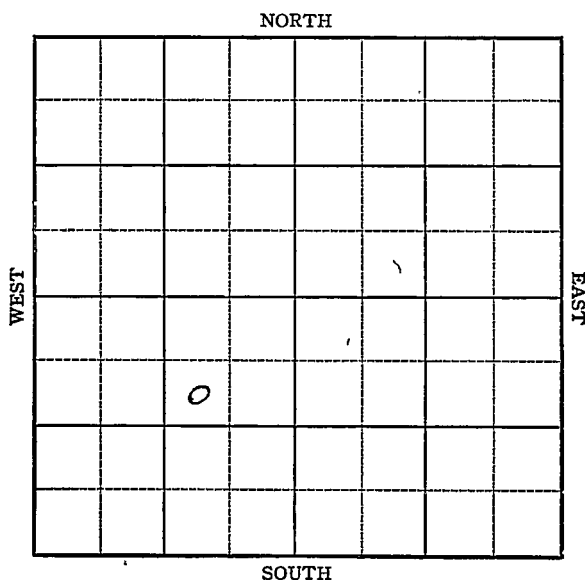


KANSAS

Butler

Section 17 Township 25 Range 5-EWell No. #3 Robinson "A"Company Harry Wilson

KANSAS

Butler

Sec. 17 Twp. 25 R. 5-E

Well No. #3 Robinson "A" Farm


Harry Wilson Company

990 Ft. from N. Line

 Ft. from S. Line

990 Ft. from E. Line

 Ft. from W. Line

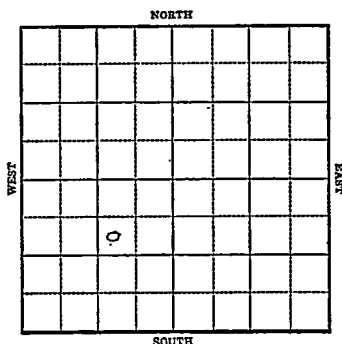

1943

R E P O R T

12-22 Cable rig

12/29 "

1944

1-5 " "

1-12 " "

1/19 Drlg. 540

1/26 15" @ 240

12" @ 878

Drlg. 1215

2/2 10" @ 1671

Drlg. 1765

2/8 Lans 1765

KC 2075

BKC 2225

Drlg. 2400

2/15 Miss 2512-14 TD

SO

6" @ 2512

S) 2551-53 TD

OVER

1944

2/23

6" @ 2512

Miss 2512

TD 2553

~~ABANDONED~~ }

ABANDONED


KANSAS

Map No. 14 Sec. 17 Twp. 25 R. 5EWell No. 3 Robinson "A"Harry Wilson CompanyFIRST REPORT Contractor

SW NE SW

990 Ft. from N. Line Ft. from S. Line990 Ft. from E. Line Ft. from W. Line

SECTION PLAT

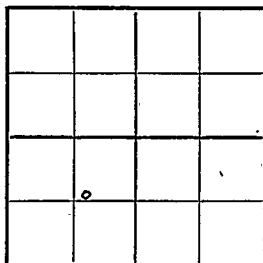

Miscellaneous

Location Rig up

Drilling and Remarks:

Cable

RECORD

Cased in., ft.Sand Gas Oil Total Depth

PRODUCTION

1st 24 hrs. Nat. 1st 24 hrs. after shot Gas Cu. Ft.Dry Hole Abandoned

Date

DEC 22 1943

19

S. J. LEWIS

Scout

Map No. KANSAS Sec. 17 Twp. 25 R. 5E

Well No. 3 Robinson "A"

Harry Wilson Company

~~ABANDONED~~ **ABANDONED** Contractor

SW NE SW

SECTION PLAT

990 Ft. from N. Line

 Ft. from S. Line

990 Ft. from E. Line

 Ft. from W. Line

	o		

Miscellaneous

Location

Rig up

Drilling and Remarks:

Miss 2512.

6" C 2512

Water

RECORD

Cased in., ft.

Sand

Gas

Oil

Total Depth 2553

PRODUCTION

1st 24 hrs. Nat.

1st 24 hrs. after shot

Gas Cu. Ft.

Dry Hole

Abandoned 2553


Date

FEB 23 1944 19 S. L. LEWIS Scout

3/1/44

Is this a dry hole or comp. you did
not show any production. Will you
please check.

Thanks
Madge

 

Small Maps *No Small Map Omaha*
Is *Madge*
Using *M.E. L*
France Map
Scarborough Map
Goody Map ☒
Ecological Dept.
Goody Plat Book