


Section 17 Township 16 Range 11-W

Well No. #1 C. Ney EAST

Company Black-Marshall

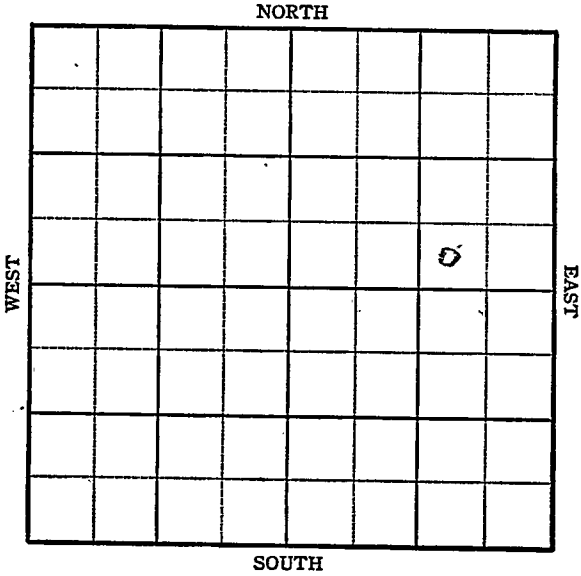

KANSAS

Sec. 17 Twp. 16 R. 11-W

Well No. #1 C. Ney "EAST" Farm


Black-Marshall Company

 Ft. from N. Line

330 Ft. from S. Line

990 Ft. from E. Line

 Ft. from W. Line

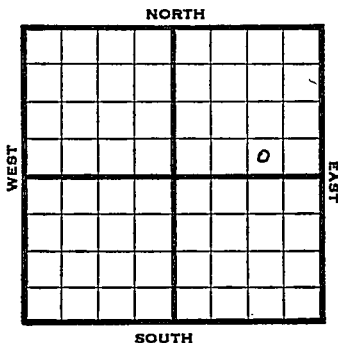

SW SE NE

1945 Elev. 1815'

R E P O R T

12/12 Location

12/20 R.U.R.

12/29 "

1946

1/10 "

1/17 "

1/24 "

1/31 "

2/6 "

2/14 Drlg. 230'

2/21 15" - 210'

Drlg. 640'

2/28 Anhy 666' Drlg. 1525'

3/7 Drlg. 2310'

3/14 2396' run 8".

3/21 8" - 1971' Dodge 2872'

Drlg. 2444'

3/28 7" - 3106' Drlg. 3180'

4/3 Cong 3251

TD 3300

ABANDONED

KANSAS Kansas Pool Name Kraft-Prusa

Map No. K-60 Sec. 17 Twp. 16 R. 11W

Well No. 1 C. Nev "EAST"

Black*Marshall Company

FIRST REPORT

Contractor

SW SE NE

SECTION FLAT

 Ft. from N. Line

330 Ft. from S. Line

990 Ft. from E. Line

 Ft. from W. Line

Barton Co. ty

Location X

Rig up

Drilling and Remarks:

RECORD

Cased in., ft.

Sand

Gas

Oil

Total Depth

PRODUCTION

1st 24 hrs. Nat.

1st 24 hrs. after shot

Gas Cu. Ft.

Dry Hole

Abandoned

Date

DEC 1 2 1945 19

S. J. LEWIS Scout

KANSAS Kansas Pool Name Kraft-Prusa

Map No. 515 Sec. 17 Twp. 16 R. 11W

Well No. 1 C. Ney "East"

Black-Marshall Company

ABANDONED Contractor

SW SE NE

E. 1815
SECTION PLAT

 Ft. from N. Line

330 Ft. from S. Line

990 Ft. from E. Line

 Ft. from W. Line

Barton County

Location

Rig up

Drilling and Remarks:

Cong 201

RECORD

Cased in., ft.

Sand

Gas

Oil

Total Depth 2300

PRODUCTION

1st 24 hrs. Nat.

1st 24 hrs. after shot

Gas Cu. Ft.

Dry Hole

Abandoned

Date

APR 3 1946 19

S. J. LEWIS Scout