KANSAS

FORM 51 5M 4-41 PETROL

O.W.D.D


Barton

Section 17 Township 16 Range 11-W

Well No. #2 Oeser

Company Harry Gore

Kraft Prusa Pool

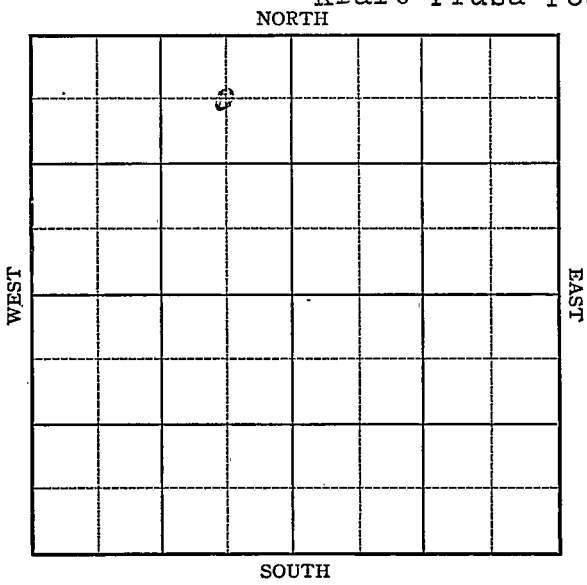

FORM 252-A 5M 6-41 PETROL KANSAS Barton

Sec. 17 Twp. 16 R. 11-W

Well No. #2 Oeser Farm

Harry Gore Company


(Kraft-Prusa) O. W. D. D

660 Ft. from N. Line

Ft. from S. Line

660 Ft. from E. Line

Ft. from W. Line

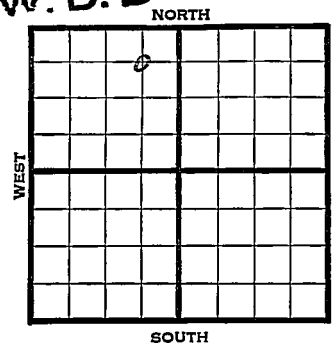

Elev. 1850

1942	REPORT
5/20	Derrick.
5/27	15" - 455' Drlg.
6/3	Anhy. 700' 10" - 710'
	Drlg. 1875'
6/10	8" - 2085' T.D. 2185' U.R. 8".
6/17	8" - 2420' Drlg. 2680'
6/24	Topeka 2635' Lans. 2995'
	T.D. 3020' U.R. 7".
7/1	Lans. 2971' 7" - 3058' Drlg. 3064'
7/8	T.D. 3068' Flow 20 oil in 6 hours.
7/15	6000 acid. Flow 335 oil 12 hours.
7/22	" " " " " "
7/29	" " " " " "
8/5	" " " " " "
8/12	" " " " " "
8/19	Lans. 2971 7" - 3058
	TD 3068 6000 acid
	Bomb Pot. 2157
	Gravity 43.6 COMPLETED
	OVER

O.W.D.D

1952

7/30 Oil Well TD 3291
Lans. 2925 OTD 3068
7" @ 3058
Cong 3278 Arb. 3280
TD 3291 CO to 3291
FU 700' oil in hole 13 hr.
Comp. 140 bopd

FIRST REPORT
COMPLETED

Form 26 200 Bks. 5-41 McW. Barton KANSAS

Map No. 55 Sec. 17 Twp. 16 R. 11W

Well No. 2 Oeser

Harry Gore Company

FIRST REPORT Contractor

C NE NW


660 Ft. from N. Line

____ Ft. from S. Line

660 Ft. from E. Line

____ Ft. from W. Line

SECTION PLAT

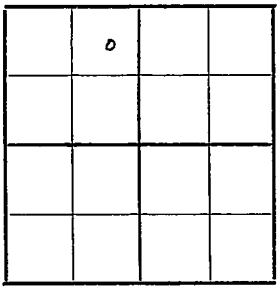

KRAFT PRUSA POOL

Location

Rig up

Drilling and Remarks:

Derrick

RECORD

Cased ____ in., ____ ft.

Sand

Gas

Oil

Total Depth

PRODUCTION

1st 24 hrs. Nat.

1st 24 hrs. after shot

Gas ____ Cu. Ft.

Dry Hole

Abandoned

Date

MAY 20 1942 19 S. J. LEWIS Scout

Form 26 200 Bks 5-42 Petrol

Barton KANSAS

Map No. 55 Sec. 17 Twp. 16 R. 11W

Well No. 2 Oeser

Harry Gore Company

COMPLETED Contractor

C NE NW


660 Ft. from N. Line

Ft. from S. Line

660 Ft. from E. Line

Ft. from W. Line

SECTION PLAT

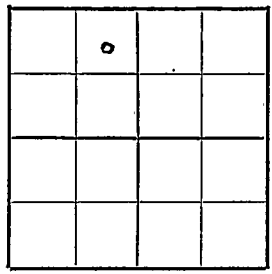

KRAFT PRUSA POOL

Location

Rig up

Drilling and Remarks:

Lime 2971

7" @ 3058

6800 Reed

Bom & Rd 2157

43 & Gr

RECORD

Cased in., ft.

Sand

Gas

Oil

Total Depth 3068

PRODUCTION

1st 24 hrs. Nat.

1st 24 hrs. after shot

Gas Cu. Ft.

Dry Hole

Abandoned

Date

AUG 19 1942 19 S. J. LEWIS Scout

FORM 275 FOR SALE BY KANSAS BLUE PRINT CO.


County Barton State Kansas

Sec. 17 (Blk. Twp.) 16 (Sur. Rge.) 11W Map No.

Operator Harry Gore

Well No. 2 Farm F. F. Oeser

Elev. 1850 Location C NE NW

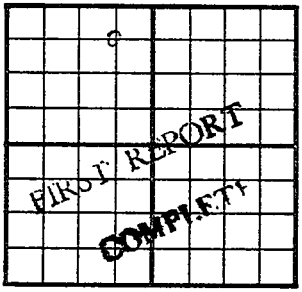

660 Ft. From N Line NW

660 Ft. From E Line Quarter

1st. Report JUL 30 1952

Completion JUL 30 1952

Remarks OWDD

Spudding Date O. W. D. D

Drlg. Data Oil well TD 3291

Lans. 2925 OTD 3068 7" @ 3058

Cong. 3278 Arb. 3280 TD 3291

CO to 3291 FU 700' oil in hole 13 hr.

Comp. 140 bopd

J. G. McGEHEE