

KANSAS

Barton


FORM 51 5M 1-42 PETROL

Section 17 Township 16 Range 11-W

Well No. 1 Oeser

Company Harry Gore

NORTH Kraft-Prusa Pool

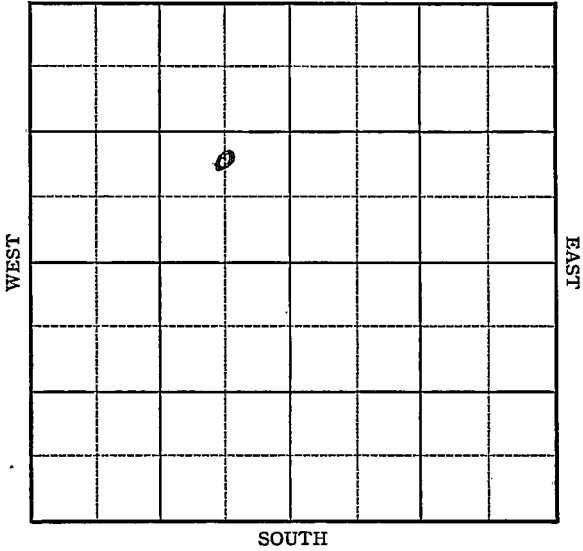

1942

5/13

Lans. 3007'

7" - 3072'

T.D. 3079'

6000 acid.

Potential 306 bbls., flow.

6 $\frac{1}{2}$ M gas.

43.6 Gravity

COMPLETED

Map No. 55 Sec. 17 Twp. 16 R. 11W

Well No. 1 Oeser

Harry Gore Company

FIRST REPORT Contractor

C NL SE NW


_____ Ft. from N. Line

990 Ft. from S. Line

660 Ft. from E. Line

_____ Ft. from W. Line

SECTION PLAT

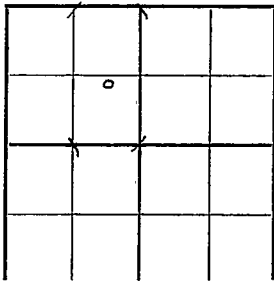

KRAFT PRUSA POOL

Location XX

Rig up _____

Drilling and Remarks:



RECORD

Cased _____ in., _____ ft.

Sand _____

Gas _____

Oil _____

Total Depth _____

PRODUCTION

1st 24 hrs. Nat. _____

1st 24 hrs. after shot _____

Gas _____ Cu. Ft.

Dry Hole _____

Abandoned _____

Date

MAR 4 1942 19

S. J. LEWIS Scout

