


~~SUSSEX~~  
KANSAS

Section 17 Township 16 Range 11 W

Well No. # 2 Oeser

Company G. M. R. Oil

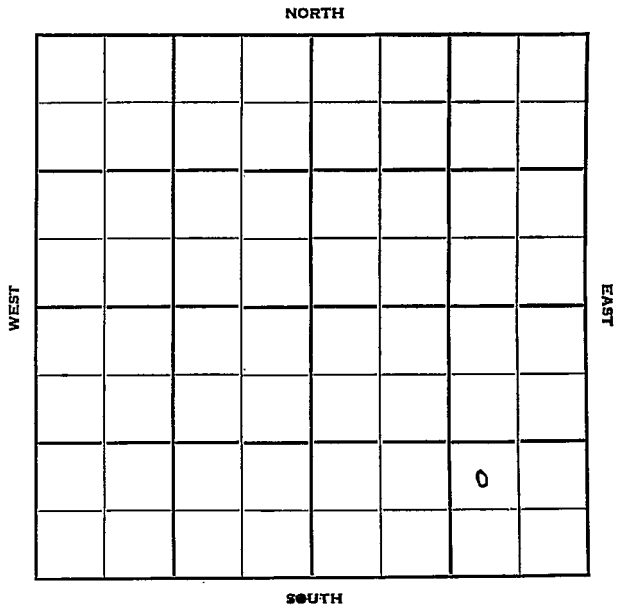

Sec. 17 Twp. 16 R. 11W

Well No. #2 Oeser Farm

G. M. R. Oil Company

G. M. R. Oil - Contr. Contractor

Kraft Prusa


Ft. from N. Line

990' Ft. from S. Line

990' Ft. from E. Line

Ft. from W. Line

NW SE SE

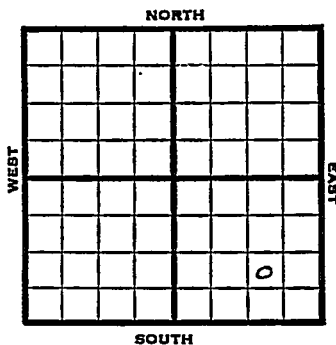

1951 Elev. 1828' REPORT

7/11 Spud 7-5-51  
8" @ 560  
Anhy 682  
Drlg. 2785'

8/22 Spud 7-5-51  
D & A TD 3380' 8" @ 560'  
Anhy 682' Heeb 2866' Br. lime 2966'  
Lans. 2985'  
DST 2986-3020 open 1/2 hr. rec 15' mud  
Cng 3286' Arb. 3298'  
DST 3298-3307 open 1 hr. rec 45' mud  
Reagan 3364-80' TD 5" @ 3350'  
CO to 3346' 24/3302-08 S/1/2 BWPB  
24/3282-88' 16/3235-39 16/3211-15  
SP 3260' 1000 A SP 3204'  
12/3190-93 16/3173-77 16/3165-69  
1000 A S/1/2 BO 1 BWPB SP 3156'  
12/3148-51 24/3130-36 1000 A  
S/4 BO 10 BWPB  
D & A

ABANDONED



