

KANSAS

Form 51-5M-7-40-Palace


Barton

Section 17 Township 16 Range 11-W

Well No. #2 Oeser

Company Shell

NORTH Prusa Pool

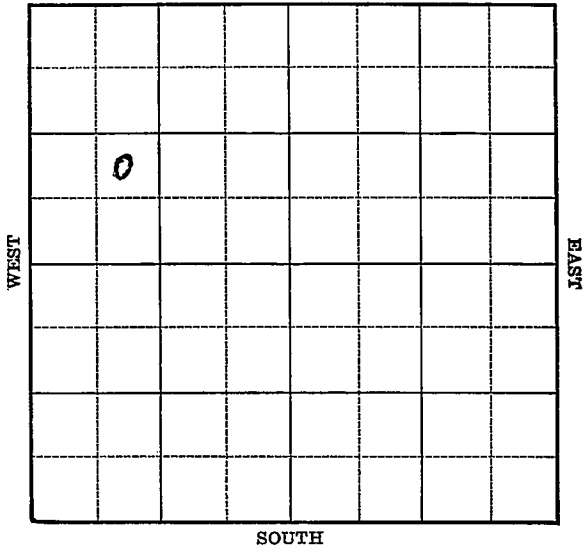

Map No. 55 Sec. 17 Twp. 16 R. 11W

Well No. 2 Oeser

Shell Company

Contractor

COMPLETED

SECTION PLAT

NE SW NW

 Ft. from N. Line

991 Ft. from S. Line

 Ft. from E. Line

989 Ft. from W. Line

PRUSA POOL

o			

Location

Rig up

Drilling and Remarks:

Cr 8296
4" 8297
1000 acid
Depth 81005

RECORD

Cased in., ft.

Sand

Gas

Oil

Total Depth 3816

PRODUCTION

1st 24 hrs. Nat.

1st 24 hrs. after shot

Gas Cu. Ft.

Dry Hole

Abandoned

Date

NOV 6 1940

S. J. LEWIS Scout