


Section 25 Township 32 Range 4E

Well No. #5 Gann

Company H. H. Blair

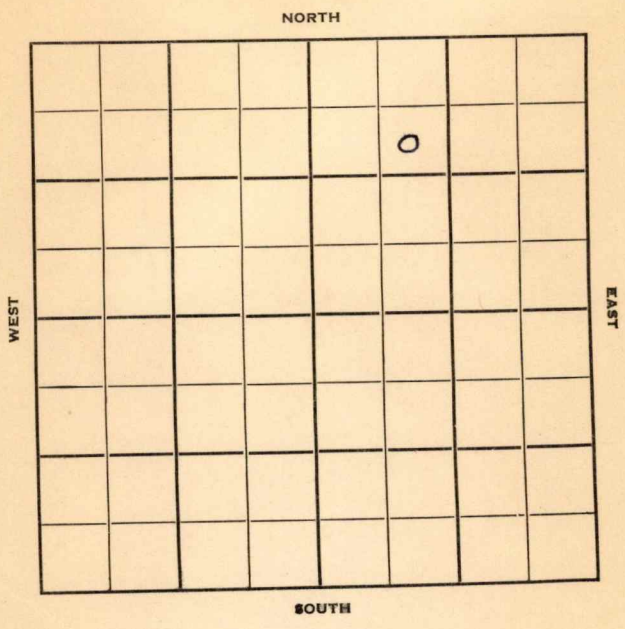

Cowley

KANSAS ✓

Sec. 25 Twp. 32 R. 4E

Well No. #5 Gann Farm _____

H. H. Blair Company _____

Contractor _____


990 Ft. from N. Line

_____ Ft. from S. Line

_____ Ft. from E. Line

990 Ft. from W. Line

SE NW NE

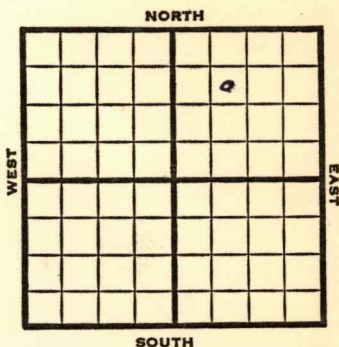

1952

Elev. 1262' REPORT

10/8

MICT

12/17

Spud 10-21-52

D&A

TD 2383'

13" @ 360

Stal. 1992

10" @ 2092

TD 2383

8" @ 2184

11/2137-40

9 go 12 gw

D&A

ABANDONED

