


Section 17 Township 17 Range 30 W

Well No. # 1 Brunner

Company J. S. Woodward

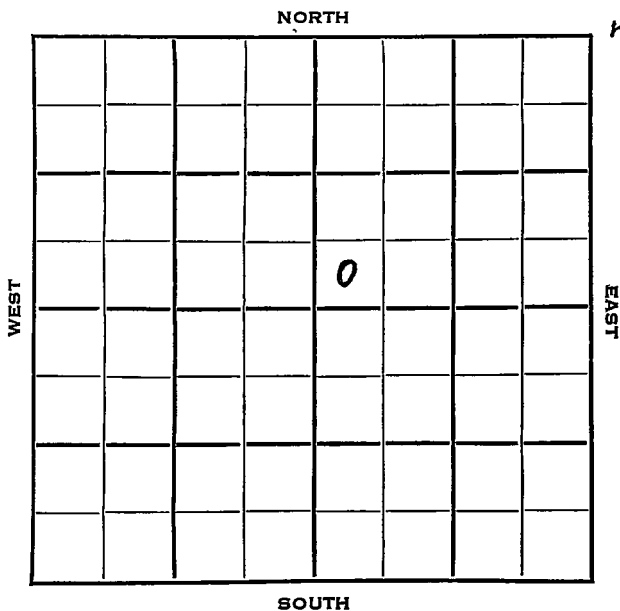

Lane

KANSAS

| | | |
|------|------|-------|
| SEC. | TWP. | R. |
| 17 | 17 | 30W ✓ |

WELL NO.

#1 Brunner

FARM

COMPANY

J.S. Woodward

CONTRACTOR

Rine Drlg.

Wildcat.

Ft. from N. Line


330

Ft. from S. Line

Ft. from E. Line

330

Ft. from W. Line

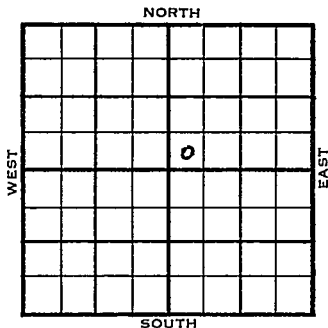

SW SW NE

Amerada - acreage

| | | |
|------|--------------------|--------|
| 1953 | ELEVATION 2889' | REPORT |
|------|--------------------|--------|

10/14

Spud 10-9-53
10" @ 319'

Miss Test.

Drlg 1202'

10/21

DST 4060-80, 1 hr, 2500' SW 1200#
Drlg. 4281'

10/28

Spud 10-9-53 D & A TD 4712'
10" @ 319 Heeb 3908' Lans 3944'
B KC 4330' Miss 4571'
DST 4060-80 open 1 hr rec 2500' SW
1200# TD 4712' D & A**ABANDONED**

County Lane State Kansas

Sec. 17 (Blk. 17) (Sur. 30W) (Twp. 17) (Rge. 30W) Map No.

Operator J. S. Woodward

Well No. 1 Farm Brunner

Elev. _____ Location SW SW NE

| | | | | |
|--------------|--|---|--|--|
| | | | | |
| | | | | |
| | | | | |
| | | 0 | | |
| | | | | |
| FIRST REPORT | | | | |

330 Ft. From S Line NE

330 Ft. From W Line Quarter

1st. Report OCT 14 1953

Completion Miss. test

Remarks Amerada - acreage

Rine Drlg. - Contr.

Spudding Date 10-9-53

Drlg. Data Wildcat

10" @ 319 drlg. 1202

