

KANSAS

Butler County


FORM 51 IOM 12-46 PETROL

Section 17 Township 25 Range 5-E

Well No. 8 Robertson "A"

Company Wilson Oil (Robinson)

Miscellaneous

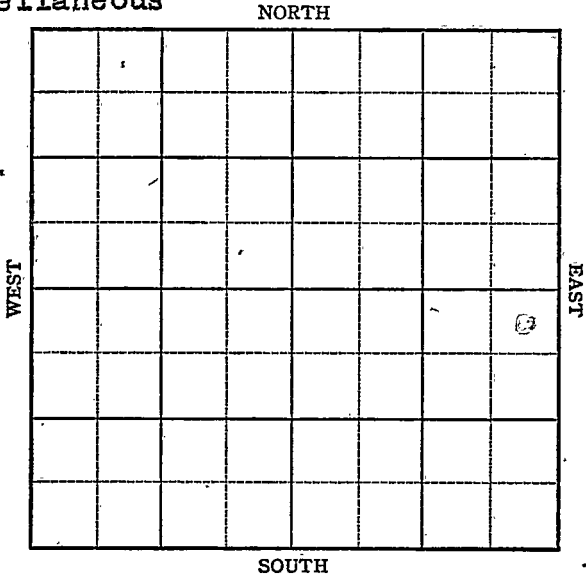

Map No. _____ Sec. 17 Twp. 25 R. 5E

Well No. 8 Robertson "A"

Wilson Oil _____ Company

FIRST REPORT

Contractor _____

NE SE

SECTION PLAT

330 Ft. from N. Line

_____ Ft. from S. Line

330 Ft. from E. Line

_____ Ft. from W. Line

			o

Butler County

Location _____

Rig up _____

Drilling and Remarks:

drlg. 170

RECORD

Cased _____ in., _____ ft.

Sand _____

Gas _____

Oil _____

Total Depth _____

PRODUCTION

1st 24 hrs. Nat. _____

1st 24 hrs. after shot _____

Gas _____ Cu. Ft.

Dry Hole _____

Abandoned _____

Date -

JUL 16 1947

19

S. J. LEWIS Scout

Map No. 14 Sec. 17 Twp. 25 R. 5E

Well No. 8 Robertson "A"

Wilson Oil Company

COMPLETE

Contractor

NE SE

E. I. 1850
SECTION PLAT

330 Ft. from N. Line

_____ Ft. from S. Line

330 Ft. from E. Line

_____ Ft. from W. Line

			o
			.

Butler County

Location _____

Rig up _____

Drilling and Remarks:

Misc 2445
7' @ 2460
Pump off

450 lbs

RECORD

Cased _____ in., _____ ft.

Sand _____

Gas _____

Oil _____

Total Depth 2505

PRODUCTION

1st 24 hrs. Nat. _____

1st 24 hrs. after shot _____

Gas _____ Cu. Ft.

Dry Hole _____

Abandoned _____

Date

AUG 20 1947 19

S. J. LEWIS

Scout