
Wichita KANSAS

FORM 51

Section 12 Township 17 Range 37W

Well No. #1 Lindberg

Company Rooney-Siegfried & Thomas

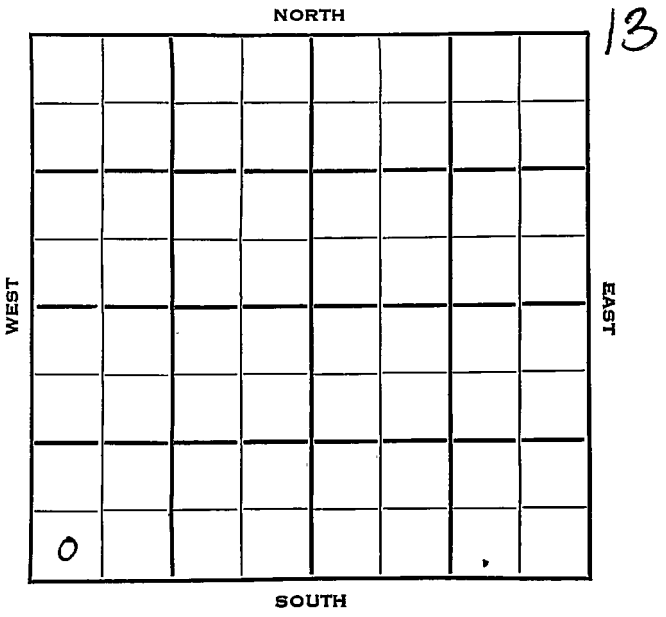

Wichita KANSAS

SEC.	TWP.	R.
12	17	37W

WELL NO.

#1 Lindberg FARM

COMPANY

Rooney-Siegfried & Thomas

CONTRACTOR

Schaffer


Wildcat

_____ Ft. from N. Line

330 Ft. from S. Line

_____ Ft. from E. Line

330 Ft. from W. Line

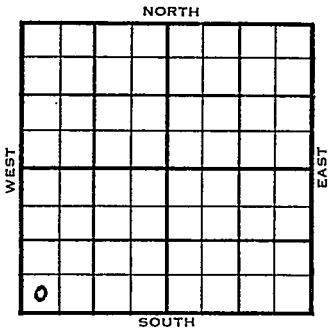

SW SW SW

Carter - DHM & Ac.

	ELEVATION	REPORT
1953	3268'	
11/11	Location	
11/11	Location	
11/18	10" @ 268' Lost circu @ 1211'	
12/2	Spud 11-13-53 D&A TD 4980' 10" @ 268' Heeb 3948', Dodge 3961', Lans 3996', Miss 4879' TD 4980' Schlumberger Tops: Heeb 3948', Dodge 3964', KC 3996', B KC 4392', Miss 4877' D&A	

ABANDONED

DX-78

FORM 275 FOR SALE BY KANSAS BLUE PRINT CO.

County Wichita State Kansas

Sec. 12 (Blk. Twp.) 17 (Sur. Rge.) 37W Map No.

Operator Rooney-Siegfried & Thomas

Well No. 1 Farm Lindberg

Elev. Location SW SW SW



330 Ft. From S Line SW

330 Ft. From W Line Quarter

1st. Report NOV 11 1952

Completion

Remarks Carter - DHM & AC

Schaffer - Contr.

Spudding Date 11-

Drlg. Data Wildcat

Location

J. G. McL. H.

FORM 275 FOR SALE BY KANSAS BLUE PRINT CO.


County Wichita State Kansas

Sec. 12 (Blk. Twp.) E7 (Sur. Rge.) 37W Map No.

Operator Rooney-Siegfried & Thomas

Well No. 1 Farm Lindberg

Elev. 3268 Location SW SWsW

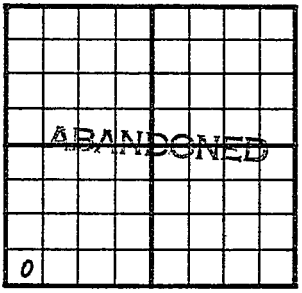

330 Ft. From S Line SW

330 Ft. From W Line Quarter

1st. Report

Completion DEC 2 1953

Remarks Wildcat

Schaffer - Contr.

Spudding Date 11-13-53

Drlg. Data D & A TD 4980

10" @ 268 Heeb. 3948 Dodge 3961

Lans. 3996 Miss. 4879 TD 4980

SCHLUMBERGER TOPS:

Heeb. 3948 Dodge 3964 KC 3996

B KC 4392 Miss. 4877

D & A

J. G. McGEHEE