

KANSAS

Butler

Section 17 Township 25 Range 5E

~~#6 Robinson B~~

Well No. 11 Robinson "A"

Company Darling Oil Company

NORTH

WEST

EAST

0/

SOUTH

Butler

KANSAS ✓
~~4E~~ SE

Sec. 17 Twp. 25 R.

Well No. ~~#11~~ #6 Robinson ~~"B"~~ "A" Farm

Darling Oil Company


Contractor

990 Ft. from N. Line

Ft. from S. Line

330 Ft. from E. Line

330 Ft. from W. Line
SW NW SW

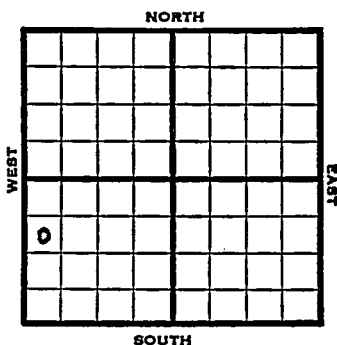

1952 Elev. 1392' REPORT

12/17 RUR

1953
1/23

Spud 12-18-52
Oil well TD 2547' 13" @ 865
8" @ 2150 Miss 2517'
7" @ 2520 TD 2547
Comp. 20 BOPD

COMPLETED

Map No. _____ Sec. 17 Twp. 25 R. 5E

Well No. 6 Robinson "B"

Darling Oil Company

CORRECTION Contractor

SW NW SW

SECTION PLAT

990 Ft. from N. Line

_____ Ft. from S. Line

_____ Ft. from E. Line

330 Ft. from W. Line

o			

Butler County

RECORD

Location _____

Cased _____ in., _____ ft.

Rig up _____

Sand _____

Drilling and Remarks:

Gas _____

Oil _____

Total Depth _____

Reported

17-25-4E

PRODUCTION

1st 24 hrs. Nat. _____

1st 24 hrs. after shot _____

Gas _____ Cu. Ft.

Dry Hole _____

Abandoned _____

Date

DEC 30 1952

J. G. McGEHEE

19

Scout

Map No. _____ Sec. 17 Twp. 25 R. 5EWell No. 11 Robinson "A"Darling Oil CompanyCORRECTION Contractor

SW NW SW

SECTION PLAT

990 Ft. from N. Line

_____ Ft. from S. Line

_____ Ft. from E. Line

330 Ft. from W. Line

Butler County

Location _____

Rig up _____

Drilling and Remarks _____

Reported
#6 Robinson "B"

RECORD

Cased _____ in., _____ ft.

Sand _____

Gas _____

Oil _____

Total Depth _____

PRODUCTION

1st 24 hrs. Nat. _____

1st 24 hrs. after shot _____

Gas _____ Cu. Ft.

Dry Hole _____

Abandoned _____

Date

JAN 14 1953 19J. G. McGEHEE Scout

