


# KANSAS Butler

Section 17 Township 25 Range 5E

Well No. 5 Robinson "B"

Company D.W. Darling

Misc.  
NORTH

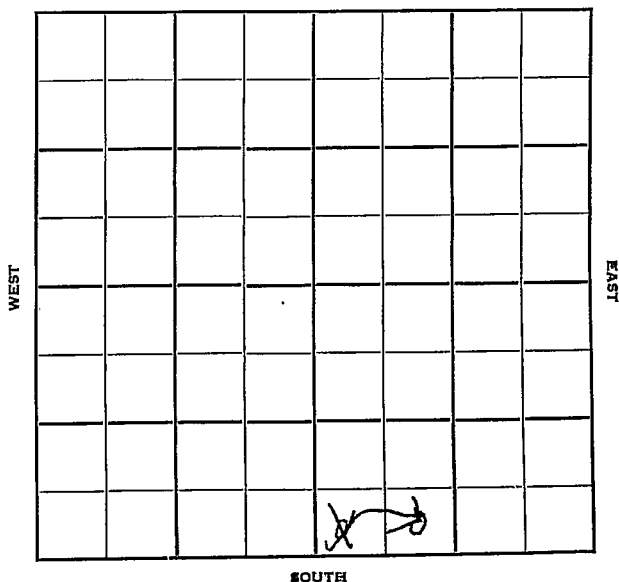

Butler

KANSAS

✓ 5E

Sec. 17 Twp. 25 R. 5E

Well No. #5 Robinson "B" Farm

D. W. Darling Company


Miscellaneous (Wixson, Cont.)

           Ft. from N. Line

280' Ft. from S. Line

           Ft. from E. Line

800  
~~300'~~ Ft. from W. Line

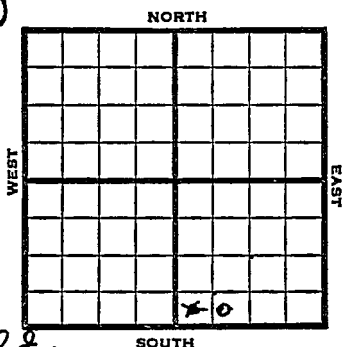

~~SW SE~~ *SE SW SE*

1949

Elev 1383' REPORT

7/6 Location  
7/13 Mach.  
7/20 15" @ 235'  
Drlg 510'  
7/27 13" @ 882'  
Drlg 1285  
8/3 Drlg. 1900'  
8/10 Drlg. 2478'  
8/17 TD 2515'  
Chat 2478'  
7" @ 2478'  
Pump 25 Oil Pot  
38° Gr.  
Comp

**COMPLETED**

**Kansas**Map No. \_\_\_\_\_ Sec. 17 Twp. 25 R. 5EWell No. 5 Robinson "B"\_\_\_\_\_  
D. W. Darling Company\_\_\_\_\_  
Wixson Contractor

SW SE

**FIRST REPORT  
SECTION PLAT**\_\_\_\_\_  
Ft. from N. Line280 Ft. from S. Line\_\_\_\_\_  
Ft. from E. Line300 Ft. from W. Line

|  |  |  |  |
|--|--|--|--|
|  |  |  |  |
|  |  |  |  |
|  |  |  |  |
|  |  |  |  |

Butler CountyLocation X

Rig up \_\_\_\_\_

Drilling and Remarks: \_\_\_\_\_

**RECORD**

Cased \_\_\_\_\_ in., \_\_\_\_\_ ft.

Sand \_\_\_\_\_

Gas \_\_\_\_\_

Oil \_\_\_\_\_

Total Depth \_\_\_\_\_

**PRODUCTION**

1st 24 hrs. Nat. \_\_\_\_\_

1st 24 hrs. after shot \_\_\_\_\_

Gas \_\_\_\_\_ Cu. Ft.

Dry Hole \_\_\_\_\_

Abandoned \_\_\_\_\_

Date

JUL 6 1949 19S. J. LEWIS Scout

Kansas


Miscellaneous

Map No. 414 Sec. 17 Twp. 25 R. 5EWell No. 5 Robinson "B"D. W. Darling \*Company**CORRECTION**

Contractor

SW SE

## SECTION PLAT

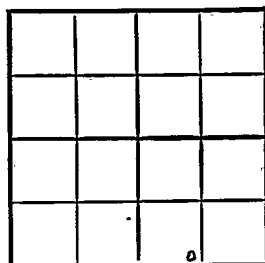       Ft. from N. Line280 Ft. from S. Line       Ft. from E. Line800 Ft. from W. Line

Butler County

Location ✓Rig up       

Drilling and Remarks:

Reported

SW SE

## RECORD

Cased        in.,        ft.Sand       Gas       Oil       Total Depth       

## PRODUCTION

1st 24 hrs. Nat.       1st 24 hrs. after shot       Gas        Cu. Ft.Dry Hole       Abandoned       

Date

JUL 13 1949

19

S. J. LEWIS

Scout

Kansas


Map No. K14 Sec. 17 Twp. 25 R. 5EWell No. 5 Robinson "B"D. W. Darling

Company

**COMPLETE**

Contractor

SE SW SE

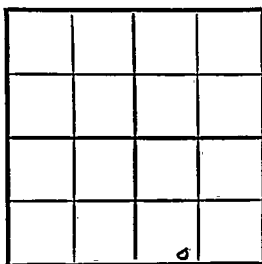E11383  
**SECTION PLAT**Ft. from N. Line280Ft. from S. LineFt. from E. Line800Ft. from W. Line

Butler County

**RECORD**

Location \_\_\_\_\_

Cased \_\_\_\_\_ in, \_\_\_\_\_ ft.

Rig up \_\_\_\_\_

Sand \_\_\_\_\_

Drilling and Remarks:

Gas \_\_\_\_\_

Oil \_\_\_\_\_

Total Depth 2515**PRODUCTION**

1st 24 hrs. Nat. \_\_\_\_\_

1st 24 hrs. after shot \_\_\_\_\_

Gas \_\_\_\_\_ Cu. Ft.

Dry Hole \_\_\_\_\_

Abandoned \_\_\_\_\_

Date

AUG 17 1949

19

S. J. LEWIS

Scout