


KANSAS

FORM 51 5M BR1X

Section 17 Township 25 Range 5E

Well No. 11 "5" Robinson

Company Darling, et al

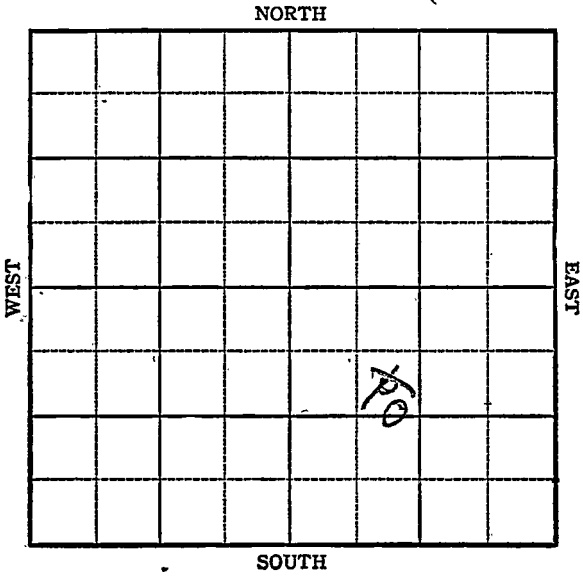


Sec. 17 Twp. 7 25 R. 5E

Well No. #11 "5" Robinson Farm
Darling et al Company

Miscellaneous

 Ft. from N. Line
1320 Ft. from S. Line
1782 Ft. from E. Line
 Ft. from W. Line
low 1372

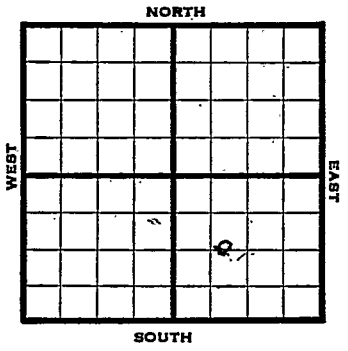

1944

REPORT

8/23	Location
8/30	"
9/8	"
9/13	"
9/21	"
9/28	"
10/4	"
10/11	"
10/18	Mach.
11/1	"
11/8	15" @ 195 Drlg.
11/16	700' Run csg.
11/24	12" @ 884 10" @ 1665 Drlg. 1808
11/29	8" @ 2115 Drlg. 2125
12/6	Miss 2405 TD 2500 Run 7#
12/14	" " " " S.D.
12/20	Miss 2405 7" @ 2511 Pump 25 Pot TD 2541 40.0 Gravity

COMPLETED

KANSAS

Pool Name Miscellaneous

Map No. 14 Sec. 17 Twp. 25 R. 5E

Well No. 11 "5" Robinson

Darling et al. Company

FIRST REPORT Contractor

SE NW SE

SECTION PLAT

_____ Ft. from N. Line

1320 Ft. from S. Line

1782 Ft. from E. Line

_____ Ft. from W. Line

Butler County

Location X

Rig up _____

Drilling and Remarks:

RECORD

Cased _____ in., _____ ft.

Sand _____

Gas _____

Oil _____

Total Depth _____

PRODUCTION

1st 24 hrs. Nat. _____

1st 24 hrs. after shot _____

Gas _____ Cu. Ft.

Dry Hole _____

Abandoned _____

Date

AUG 23 1944 19

S. J. LEWIS Scout

Pool Name MiscellaneousMap No. 14 Sec. 17 Twp. 25 R. 5EWell No. 11- "5" RobinsonDarling etal. Company**COMPLETED**

Contractor

SE NW SE

SECTION PLAT

_____ Ft. from N. Line

1320 Ft. from S. Line1782 Ft. from E. Line

_____ Ft. from W. Line

Butler

Location _____

Rig up _____

Drilling and Remarks:

*Misc 2405**7" @ 2511**Pump 25 Rod**40° Gr***RECORD**

Cased _____ in., _____ ft.

Sand _____

Gas _____

Oil _____

Total Depth 2541**PRODUCTION**

1st 24 hrs. Nat. _____

1st 24 hrs. after shot _____

Gas _____ Cu. Ft.

Dry Hole _____

Abandoned _____

Date

DEC 20 1944 19S. J. LEWIS

Scout