


Section 25 Township 32 Range 4 E

Well No. # 3 Lorton

Company H. H. Blair & E. Wakefield

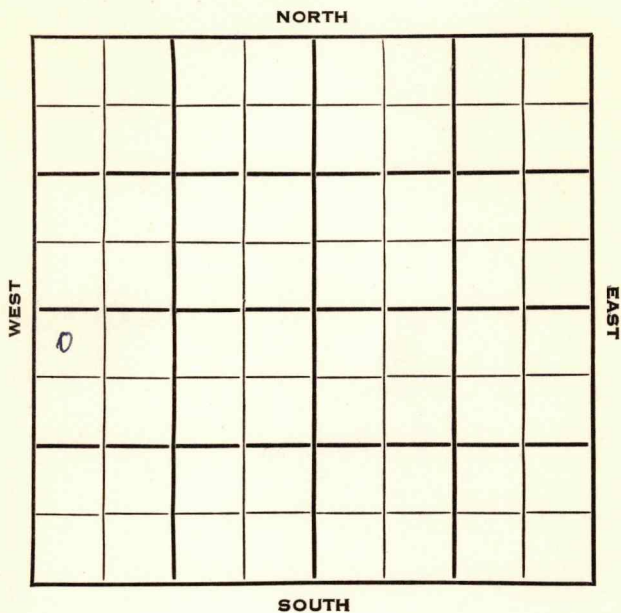

Cowley

KANSAS

SEC.	TWP.	R.
25	32	4 E ✓

WELL NO.

3 Lorton

FARM

COMPANY

H. H. Blair & E. Wakefield

CONTRACTOR

Wakefield

Winfield Pool


330 Ft. from N. Line

Ft. from S. Line

Ft. from E. Line

330 Ft. from W. Line

NW NW SW

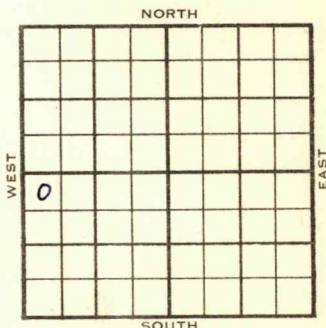

1954

ELEVATION

1198'

REPORT

4/14

Cellar & Pits

5/12

Spud 4-16-54

Oil Well

TD 2925'

8" @ 99'

Stal. 1992', Layton 2362', KC 2505'

B KC 2608', Bart 2901',

TD 2914'

5" @ 2906'

DD 2925'

sd-frac.

F/ 65 boph

Comp 25 bopd.

COMPLETED

