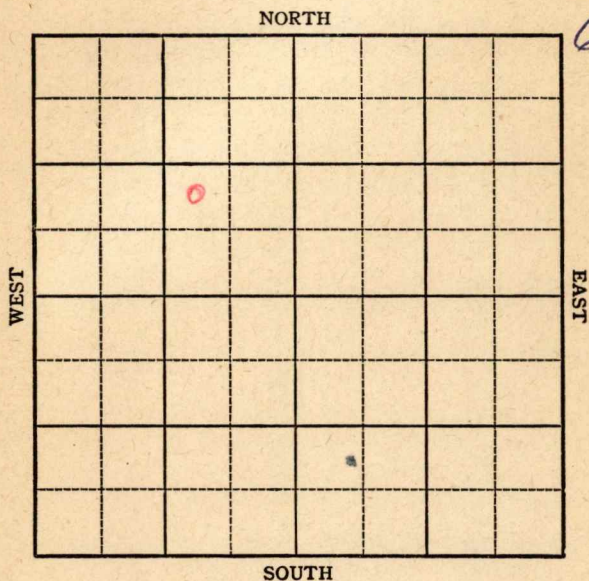


KANSAS

Cowley county

Section 7 Township 35 Range 3-EWell No. "2 Finch "C"Company Hill & Hill

Sec. 7 Twp. 35 R. 3-E

Well No. #2 Finch "C" Farm

Hill & Hill Company


Miscellaneous

Ft. from N. Line

990 Ft. from S. Line

990 Ft. from E. Line

Ft. from W. Line

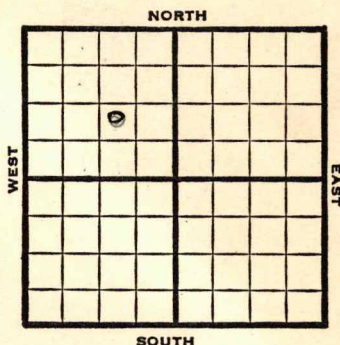

NW SE NW

REPORT

1947 1196

2/5	8" @ 138' Drlg 2050'
2/12	Drlg 3207'
2/19	Bart 3459(TD 3487' 7" @ 3450' RUST
2/26	Miss 3515 TD 3516' 2000' Oil
3/4	TD 3516' PB 3514 150 qts 3466-3514 CO
3/11	Swb 5 bbls oil & 20 W PH
3/18	SD
3/25	"

OVER

4/2

Bart. 3459'

Miss. 3515'

7" @ 3450'

1509 Ts

Pump 75 Oil & 40 w pot

39.0 Gr.

TD 3516'.

COMPLETED


Map No. Sec. 7 Twp. 35 R. 3EWell No. 2 Finch "C"Hill & Hill Company

FIRST REPORT

Contractor

NW SE NW

SECTION PLAT

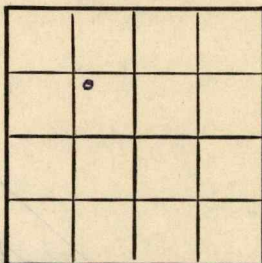 Ft. from N. Line990 Ft. from S. Line990 Ft. from E. Line Ft. from W. LineCowley CountyLocation Rig up

Drilling and Remarks:

8" @ 138

drlg. 2050

RECORD

Cased in., ft.Sand Gas Oil Total Depth

PRODUCTION

1st 24 hrs. Nat. 1st 24 hrs. after shot Gas Cu. Ft.Dry Hole Abandoned

Date

FEB 5 1947 19S. J. LEWIS

Scout

Map No. K1 Sec. 7 Twp. 35 R. 3E

Well No. 2 Finch "C"

Hill & Hill Company

COMPLETE Contractor

NW SE NW


E11196
SECTION PLAT

_____ Ft. from N. Line

990 Ft. from S. Line

990 Ft. from E. Line

_____ Ft. from W. Line

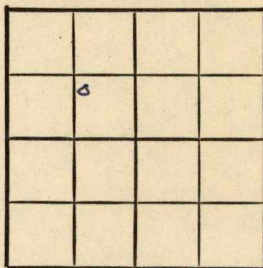

Cowley County

Location _____

Rig up _____

Drilling and Remarks:

Bar 73459
Nuis 3515
7" @ 3450
1509 ft
Pump. 2500 ft
40N Bar
39 1/2 ft

RECORD

Cased _____ in., _____ ft.

Sand _____

Gas _____

Oil _____

Total Depth 3516

PRODUCTION

1st 24 hrs. Nat. _____

1st 24 hrs. after shot _____

Gas _____ Cu. Ft.

Dry Hole _____

Abandoned _____

Date

APR 2 1947 19 S. J. LEWIS Scout