
KANSAS Barton

Form 51—5M—7-40—Palace

Section 17 Township 16 Range 11-W

Well No. 4 Ceser

Company Sinclair Prairie

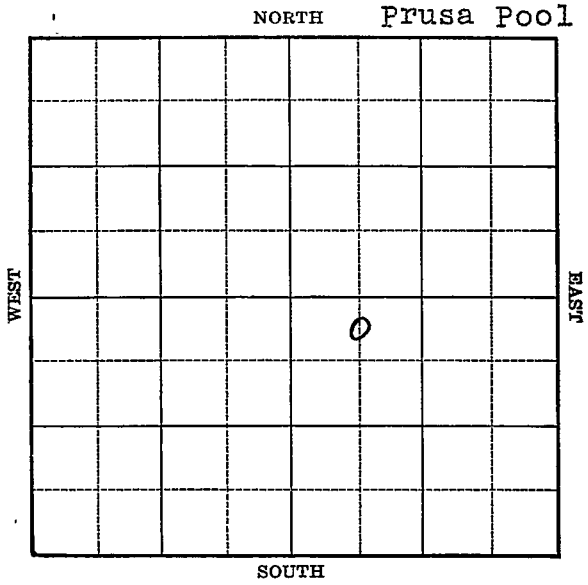

FORM 252-A 5M 1-41 PETROL

KANSAS Barton

Sec. 17 Twp. 16 R. 11-W

Well No. #4 Oeser Farm

Sinclair-Prairie Company


(Prusa)

330 Ft. from N. Line

_____ Ft. from S. Line

_____ Ft. from E. Line

660 Ft. from W. Line

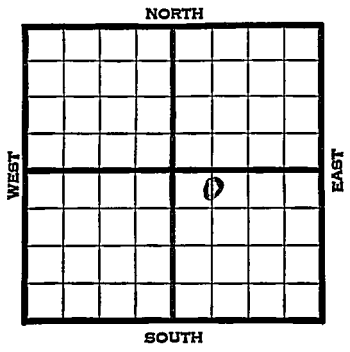

Elev. 1839

1941	REPORT
5/21	Cellar.
5/28	Surface hole.
6/5	10" - 141' Drlg. 2720'
6/12	Topeka 2625' Lans. 2973' S.O.
	Arb. 3289-91' T.D. SSO.
	5" - 3289' RUST.
6/25	Lans. 2973'
	Arb. 3289'
	5" - 3288'
	T.D. 3291'
	42 shots 3260-69'
	2000 acid.
	Potential 66 bbls., pump.
	43. Gravity
	COMPLETED

Form 26—200 Bks.—1-40—Palace Barton KANSAS

Map No. 56 Sec. 17 Twp. 16 R. 11W

Well No. 4 Oeser

Sinclair Prairie Company

FIRST REPORT Contractor

C N L NW SE

330 Ft. from N. Line


____ Ft. from S. Line

____ Ft. from E. Line

660 Ft. from W. Line

PRUSA POOL

SECTION PLAT

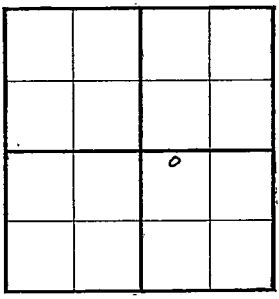

Location____

Rig up____

Drilling and Remarks:
Cellar

RECORD

Cased____ in., ____ ft.

Sand____

Gas____

Oil____

Total Depth____

PRODUCTION

1st 24 hrs. Nat.____

1st 24 hrs. after shot____

Gas____ Cu. Ft.

Dry Hole____

Abandoned____

Date

MAY 21 1941 19____ S. J. LEWIS Scout

Form 26 200 Bks. 5-41 McW. Barton KANSAS

Map No. _____ Sec. 17 Twp. 16 R. 11W

Well No. 4 Oeser

Sinclair Prairie Company

COMPLETED Contractor

C N L NW SE

330 Ft. from N. Line


_____ Ft. from S. Line

_____ Ft. from E. Line

660 Ft. from W. Line

PRUSA POOL

SECTION PLAT

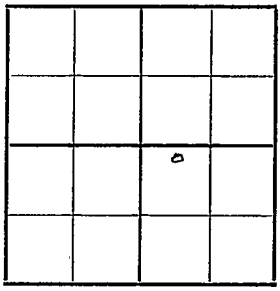

Location _____

Rig up _____

Drilling and Remarks:

Lane 2973
Cr X 3289
5" @ 3287
42 Shots 3260-69
2000 Acid
Pump 66 B X.
430 Gr

RECORD

Cased _____ in., _____ ft.

Sand _____

Gas _____

Oil _____

Total Depth 3291

PRODUCTION

1st 24 hrs. Nat. _____

1st 24 hrs. after shot _____

Gas _____ Cu. Ft.

Dry Hole _____

Abandoned _____

Date

JUN 25 1941 19 S. I. LEWIS Scout