


Barton

KANSAS

Section 17 Township 16 Range 11W

Well No. #5 Oeser

Company Sinclair

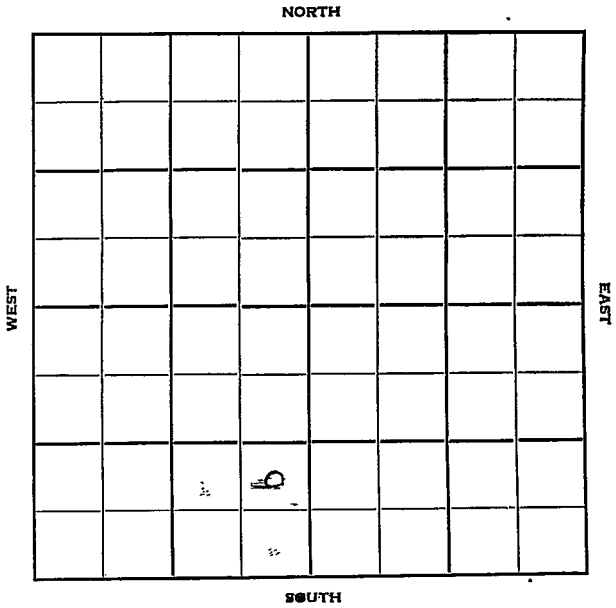

Barton

KANSAS

Sec. 17 Twp. 16 R. 11 W

Well No. # 5 M. Oeser Farm

Sinclair Company

Holm Drlg. - Contr. Contractor


 Ft. from N. Line

990 Ft. from S. Line

330 Ft. from E. Line

 Ft. from W. Line

NE SE SW

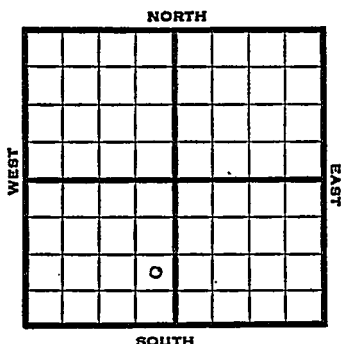

1951

Elev. 1882' REPORT

5/16

Location

6/20

Oil Well TD 3278

8" @ 289

Top 2647

Tor. 2911

Lans. 3005

5" @ 3277

48/3250-58

SP 3238

FU 1000' oil 1 hr

3000 A S/67 bo 8 hr.

Comp. 237 bopd

Heeb. 2895

Br lime 2986

Granite 3277-78 TD

Go to 3262

1000 A

46/3217-30

COMPLETED

J. E. TYRA

County Barton State Kansas

Sec.	17	(Blk.) Twp.)	16	(Sur.) Rge.)	11W	Map No.
------	----	-----------------	----	-----------------	-----	---------

Operator Sinclair

Well No. 5 Farm M. Oeser

Elev.	1882	Location	NE SE SW
-------	------	----------	----------

A 10x10 grid. The word "COMPLETE" is written diagonally across the top-left quadrant, starting from the top-left corner and ending near the center. A small circle is located in the bottom-left quadrant, near the center.

990 Ft. From S Line SW

330 Ft. From E Line Quarter

1st. Report _____

Completion JUN 20 1951

Remarks

Holm Drlg. - Contr.

Spudding Date _____

Drilg. Data Oil well TD 3278

8" @ 289 Top. 2647 Heeb. 2895

Tor. 2911 Br. lime 2986 Lans. 3005

Granite 3277-78 TD 5" @ 3277 CO to 3262

48/ 3250-58 1000 A SP 3238

46/ 3217-30 FU 1000' oil 1 hr.

3000 A S/ 67 ho 8 hr.

Comp. 237 bopd