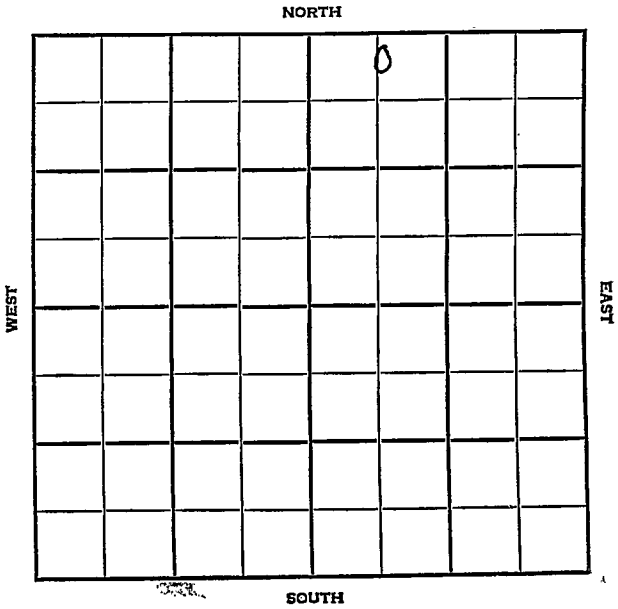


Section 17 Township 25 Range 5 EWell No. #36 L. W. RobisonCompany Texas Co.

Butler

KANSAS

SEC.	TWP.	R.
17	25	5E

WELL NO.

#36 L. W. Robison

FARM

COMPANY

Texas Co

CONTRACTOR

Shira

Eldorado

200'

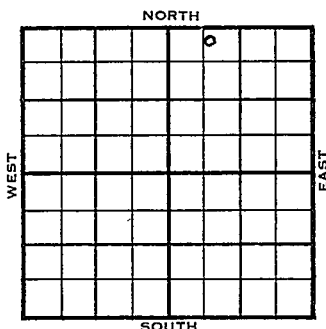
Ft. from N. Line

Ft. from S. Line

1901'

Ft. from E. Line

Ft. from W. Line

N $\frac{1}{2}$ NW NE

1955

ELEVATION

1365'

REPORT

~~12~~

10/6

Comm 10-6-55

4" @ 688

Drlg 703

11/9

Comm 10-6-55

4" @ 688

5 1/2" @ 688

A Sand 686

TD 703

GO F/10 bsw 6 hr Comp 1/4 bopd

90 bw Waiting on water flood

COMPLETED

County Battler Elev. _____
 Sec. 17 Twp. 25 Rge. 5E
 Company Texas Company
 Farm Name L. W. Robison No. 36

TOPS	DEPTH	LOG	DATUM	Loc. in Sec.
Anh.				<u>N$\frac{7}{2}$ NW NE</u>
Tr.				<u>200' NL</u>
H.				<u>1901' EL</u>
Tr.				
Dg.				
BL.				
L.				Geol. _____
K.C.				Contr. _____
B.K.C.				<u>Shira</u>
Ce.				
C.				Pool _____
M.				<u>El Dorado</u>
M.				
K.				
Mz.				
Me.				
V.				
S.				
S.				
A.				
R.				
PE.				
G.				
T.D.				

FIRST REPORT
OCT 12 '55

Date Comm. 10-6-55

1 $\frac{1}{2}$ " @ 688 drlg. 703

Co.

Lse.

No.

Sec.

T.

R.

County Butler Elev. 1365
 Sec. 17 Twp. 25 Rge. 5E
 Company Texas Company
 FarmName L. W. Robison No. 36

Co.

Lse.

No.

Sec.

T.

R.

TOPS	DEPTH	LOG	DATUM
Anh.			
Tp.			
H.			
Tr.			
Dg.			
Bl.			
L.			
K.C.			
B.K.C.			
Ce.			
C. <u>A sand</u>	<u>686</u>		
M.			
M.			
K.			
Mz.			
Me.			
V.			
S.			
S.			
A.			
R.			
Pe.			
G.			
T.D.	<u>703</u>		

Loc. in Sec.

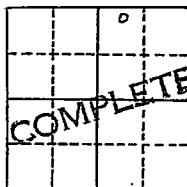
N¹/₂ NW NE200' NL1901' EL

Geol.

Contr.

Shira

Pool

ElDoradoDate Comm. 10-6-55 NOV 9 19551" @ 688 5¹/₂" @ 688 CO F/ 10 bsw6 hr. Comp. 1/4 bopd 90 bwWaiting on water flood