


Map No. _____ Sec. 25 Twp. 32 R. 4
Well No. 2 McGadden Farm _____
Rothron Oil Company _____

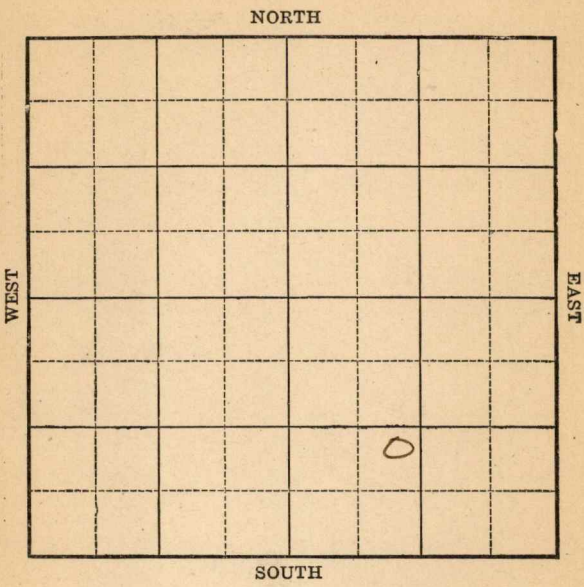

Location _____

Rig up _____

Drilling Remarks:

Drilling Remarks:

RECORD

PRODUCTION

Cased _____ in. _____ ft.

1st 24 hrs Nat. _____

Sand _____

1st 24 hrs. after shot _____

Gas _____

Gas _____ cu. ft.

Oil _____

Dry Hole _____

Total Depth _____

Abandoned _____

Map No. **KANSAS** ^v Sec. **25** Twp. **32** R. **4**
 Well No. **2 M^o Fadd**
Rathvon etal Company

Contractor

FIRST REPORT

SECTION PLAT

----- Ft. from N. Line
1120 Ft. from S. Line
 ----- Ft. from E. Line
1120 Ft. from W. Line

Location -----
 Rig up -----
 Drilling and Remarks:

Mach

RECORD

Cased ----- in., ----- ft.
 Sand -----
 Gas -----
 Oil -----
 Total Depth -----

PRODUCTION

1st 24 hrs. Nat. -----
 1st 24 hrs. after shot -----
 Gas ----- Cu. Ft.
 Dry Hole -----
 Abandoned -----

Date

M. A. BENEAR

MAR 22 1923

192

Scout

Map No. KANSAS Sec. 25 Twp. 32 R. 4

Well No. 2 m^o Fadden

Rathvon et al Company

Contractor

COMPLETED SECTION PLAT

----- Ft. from N. Line

1120 Ft. from S. Line

----- Ft. from E. Line

1120 Ft. from W. Line

		o	

Location -----

Rig up -----

Drilling and Remarks:

sand { 11485
 { 11494

20/50

RECORD

Cased ----- in., ----- ft.

Sand -----

Gas -----

Oil -----

Total Depth -----

PRODUCTION

1st 24 hrs. Nat. -----

1st 24 hrs. after shot -----

Gas ----- Cu. Ft.

Dry Hole -----

Abandoned -----

Date

JUN 10 1923

M. A. BENEAR

----- 192 ----- Scout