


Section 7 Township 35 Range 3-E

Well No. #3 Vickery "A"

Company Hill & Hill

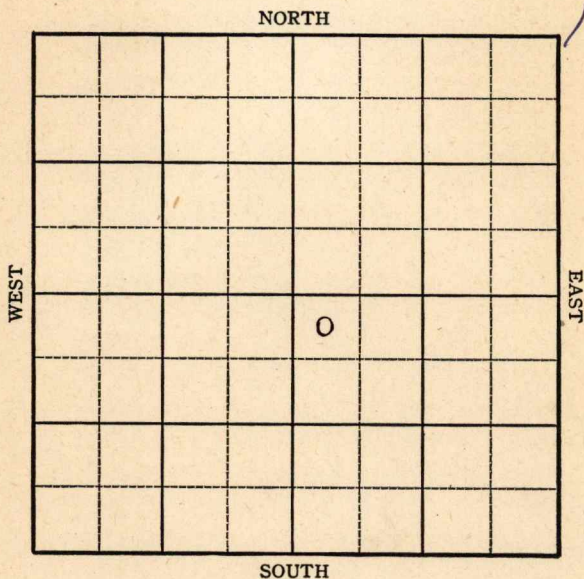

KANSAS

Cowley County

Sec. 7 Twp. 35 R. 3E

Well No. #3 Vickery "A" Farm

Hill and Hill Company

Miscellaneous


330 Ft. from N. Line

Ft. from S. Line

Ft. from E. Line

330 Ft. from W. Line

NW SE

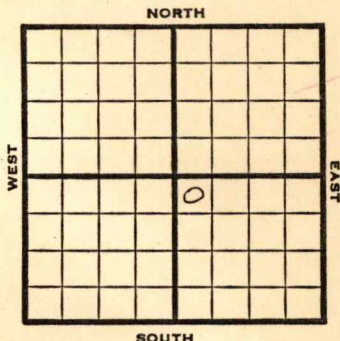

1946

Elev. 1195

REPORT

3/6

Location

3/14

Surface hole.

3/21

10" - 130' Drlg. 1550'

3/28

Drlg. 2594'

4/4

Peru 3084

Oswego 3155

Drlg. 3430

4/10

Bart 3428

7" @ 3442

TD 3487 RUST

4/16

TD 3489 125 qts 3465-89 CO

4/23

" " "

5/1

Bart 3428

7" @ 3442

TD 3489

Pump 75 Pot.

Grav. 39.0

3155
1194
1961

COMPLETED

Kansas Pool Name Miscellaneous

Map No. 1 Sec. 7 Twp. 35 R. 3E

Well No. 3 Vickery "A"

Hill and Hill

Company

CORRECTION

Contractor

NW SE

SECTION PLAT


330 Ft. from N. Line

Ft. from S. Line

Ft. from E. Line

330

Ft. from W. Line

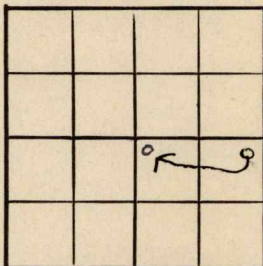

Cowley County

Location _____

Rig up _____

Drilling and Remarks:

had spotted NE SE

RECORD

Cased _____ in., _____ ft.

Sand _____

Gas _____

Oil _____

Total Depth _____

PRODUCTION

1st 24 hrs. Nat. _____

1st 24 hrs. after shot _____

Gas _____ Cu. Ft.

Dry Hole _____

Abandoned _____

Date

MAR 6 1946 19

S. J. LEWIS

Scout

~~KANSAS~~Kansas Pool Name MiscellaneousMap No. _____ Sec. 7 Twp. 35 R. 3EWell No. 3 Vickery "A"Hill & Hill


Company

FIRST REPORT

Contractor

NW SE

SECTION PLAT

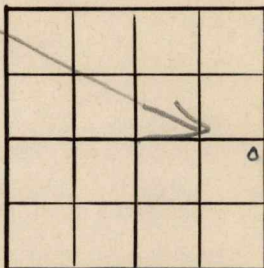330 Ft. from N. Line Ft. from S. Line330 Ft. from E. Line Ft. from W. LineCowley CountyLocation X

Rig up _____

Drilling and Remarks:

RECORD

Cased _____ in., _____ ft.

Sand _____

Gas _____

Oil _____

Total Depth _____

PRODUCTION

1st 24 hrs. Nat. _____

1st 24 hrs. after shot _____

Gas _____ Cu. Ft.

Dry Hole _____

Abandoned _____

Date

MAR 6 194619S. J. LEWISScout

Kansas Pool Name Miscellaneous

KANSAS
 Map No. Sec. 7 Twp. 35 R. 3E

Well No. 3 Vickery "A"Hill & Hill

Company

COMPLETED

Contractor

NW SE

E 11195
SECTION PLAT

		0	

330 Ft. from N. Line Ft. from S. Line Ft. from E. Line330 Ft. from W. LineCowley CountyLocation Rig up

Drilling and Remarks:

*Bar 73425**7" 6342**Pump 75 Bt**89 2/4***RECORD**Cased in., ft.Sand Gas Oil Total Depth 3485**PRODUCTION**1st 24 hrs. Nat. 1st 24 hrs. after shot Gas Cu. Ft.Dry Hole Abandoned

Date

MAY 1 1946

19

S. J. LEWIS

Scout