


Section 7 Township 35 Range 3E

Well No. 3 Vickery "B"

Company Hill & Hill

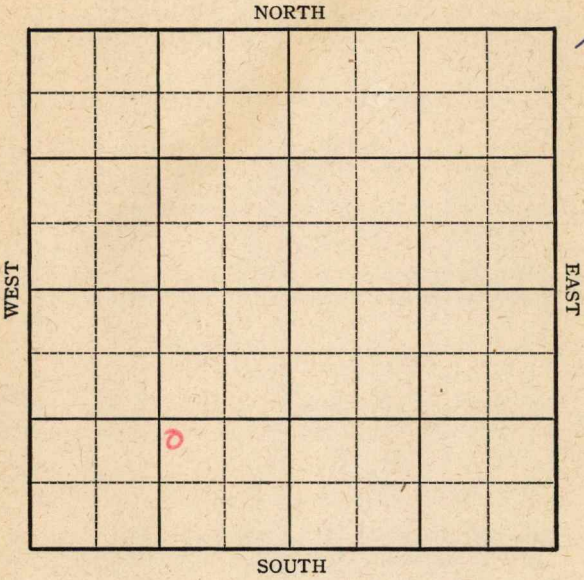

Cowley

KANSAS

Sec. 7 Twp. 35 R. 3E

Well No. 3 Vickery "B" Farm

Hill & Hill

Company


Miscellaneous

 Ft. from N. Line

990 Ft. from S. Line

990 Ft. from E. Line

 Ft. from W. Line

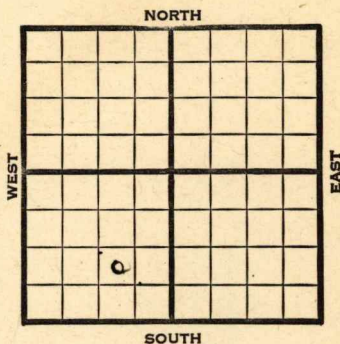

NW SE SW

1945

REPORT

6/20	10" @ 109'
	WOC
6/28	Drlg. 2462
7/3	Drlg. 3388
7/11	Bart. 3415
	7" @ 3421
	TD 3443' RUST
7/19	Miss. 3489
	TD 3517
	HFW PB 3468
7/26	60 qts. 15 Oil per hr.
8/1	Bart. 3415
	Miss. 3489
	T.D. 3517'
	P.B. 3468'
	60 qts.
	Pump 80 pot.
	Gravity 38.7

COMPLETED

Pool Name Miscellaneous
Kansas

Map No. 1 Sec. 7 Twp. 35 R. 3E

Well No. 3 Vickery "B"

Hill & Hill

Company

FIRST REPORT

Contractor

NW SE SW

SECTION PLAT

	o		

 Ft. from N. Line

990 Ft. from S. Line

990 Ft. from E. Line

 Ft. from W. Line

Cowley County

Location

Rig up

Drilling and Remarks:

10"-109 WOC

RECORD

Cased in., ft.

Sand

Gas

Oil

Total Depth

PRODUCTION

1st 24 hrs. Nat.

1st 24 hrs. after shot

Gas Cu. Ft.

Dry Hole

Abandoned

Date

JUN 20 1945 19

S. J. LEWIS

Scout

KANSAS

Kansas

Pool Name MiscellaneousMap No. 1 Sec. 7 Twp. 35 R. 3EWell No. 3 Vickery "B"Hill & Hill

Company

COMPLETED

Contractor

NW SE SW

SECTION PLAT

 Ft. from N. Line990 Ft. from S. Line990 Ft. from E. Line Ft. from W. Line

	0		

Cowley CountyLocation Rig up

Drilling and Remarks:

*Ba 3415**Mis 3485**PB 3465**609 to**Pump 80 BX**252 gr***RECORD**Cased in., ft.Sand Gas Oil Total Depth 3517**PRODUCTION**1st 24 hrs. Nat. 1st 24 hrs. after shot Gas Cu. Ft.Dry Hole Abandoned

Date

AUG 1 194519S. J. LEWIS Scout