
KANSAS – Barton

FORM 51 5M PETROL

Section 17 Township 16 Range 11W

Well No. 4 Oeser

Company Harry Gore

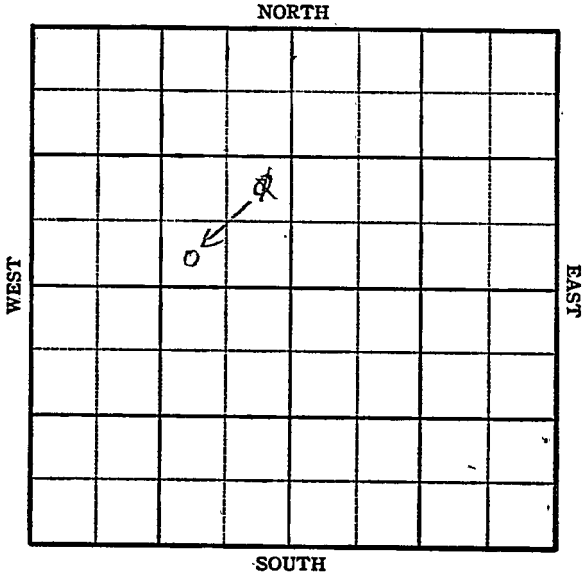

FORM 252-A
5M 8-45 PETROL

KANSAS Barton

Sec. 17 Twp. 16 R. 11-W

Well No. #4 Oeser Farm

Harry Gore Company


330 Ft. from N. Line

~~990~~ Ft. from S. Line

990

~~330~~ Ft. from E. Line

Ft. from W. Line

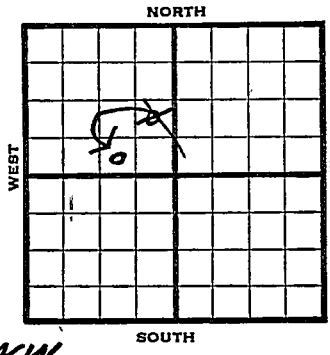

~~NE SE NW~~ SW SE NW

1945	Elev. 1880 REPORT
11/7	Location
11/14	"
11/21	Rig
11/28	"
12/5	"
12/12	"
12/20	Drlg. 385'
12/29	Drlg. 1000'
1946	
1/10	12" - 467' Anhy 727' 10" - 733' 8" - 2078' 2230' UR 8".
1/17	8" - 2476' Drlg. 2520'
1/24	Topeka 2670' Lans. 3007' T.D. 3067' 6" - 3067' RUST.
1/31	3304' UR 6".
2/6	Arb. 3306-13' T.D. S.O. 6" - 3306' RUST.
2/14	1500' oil.
2/21	1000 acid. T.D. 3317' Pump 8 oil per hour.
2/28	1500 acid. Pump 10 oil per hour 9 hours
3/6	Arb. 3306 6" @ 3306 2500 acid. TD 3317' Pump 326 oil Pot. Grav. 42.0

COMPLETED

FORM 56 200 BKSA 1-46 PETROL

KANSAS

Kansas Pool Name Kraft-Prusa

Map No. 5-S Sec. 17 Twp. 16 R. 11W

Well No. 4 Oeser


Harry Gore Company

FIRST REPORT

Contractor

NE SE NW

SECTION PLAT

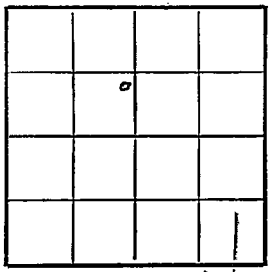

Ft. from N. Line

990 Ft. from S. Line

330 Ft. from E. Line

Ft. from W. Line

Barton County

Location x

Rig up

Drilling and Remarks:

RECORD

Cased in., ft.

Sand

Gas

Oil

Total Depth

PRODUCTION

1st 24 hrs. Nat.

1st 24 hrs. after shot

Gas Cu. Ft.

Dry Hole

Abandoned

Date

NOV 7 1945 19 S. J. LEWIS Scout

FORM 56 200 BKS, 1-44 PETROL

KANSAS Kansas Pool Name Kraft-Prusa

Map No. 55 Sec. 17 Twp. 16 R. 11W

Well No. 4 Deser


Harry Gore Company

CORRECTION

Contractor

SW SE NW

SECTION PLAT

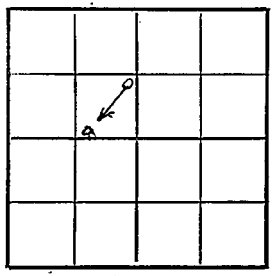

Ft. from N. Line

330 Ft. from S. Line

990 Ft. from E. Line

Ft. from W. Line

Barton County

Location

Rig up

Drilling and Remarks:

reported NE SE NW

RECORD

Cased in., ft.

Sand

Gas

Oil

Total Depth

PRODUCTION

1st 24 hrs. Nat.

1st 24 hrs. after shot

Gas Cu. Ft.

Dry Hole

Abandoned

Date

NOV 14 1945

19 S. J. LEWIS Scout

FORM 26 200 BKS 2-44 PETROL

KANSAS Kansas Pool Name Kraft-Prusa

Map No 57 Sec. 17 Twp. 16 R. 11W


Well No. 4 Oeser

Harry Gore Company

COMPLETED Contractor

SW SE NW E 1/1830

SECTION PLAT

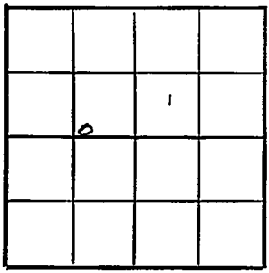

Ft. from N. Line

330 Ft. from S. Line

990 Ft. from E. Line

Ft. from W. Line

Barton County

Location

Rig up

Drilling and Remarks:

Ar 3306
6" C 3306
250 acid
Pump 326 oil
42 gr

RECORD

Cased in., ft.

Sand

Gas

Oil

Total Depth 3317

PRODUCTION

1st 24 hrs. Nat.

1st 24 hrs. after shot

Gas Cu. Ft.

Dry Hole

Abandoned

Date

MAR 6 1946 19 S. I. LEWIS Scout