


Section 24 Township 32 Range 4 E

Well No. #5-A Wallace

Company H. H. Blair

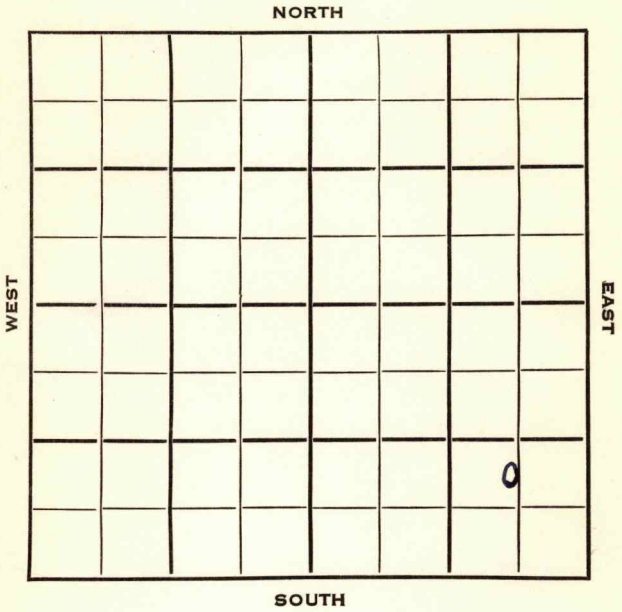



Sec. 24 Twp. 32 R. 4 E

Well No. # 5-A Wallace Farm

H.H. Blair Company

Kriswell Contractor


\_\_\_\_\_ Ft. from N. Line

990 Ft. from S. Line

790 Ft. from E. Line

\_\_\_\_\_ Ft. from W. Line

NW SE SE

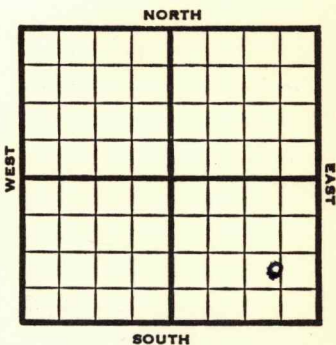

1953

**Elev. 1253'** REPORT

6/10

Spud 6-2-53  
8" @ 189  
Drlg. 2038'

7/8

Spud 6-2-53  
Oil well TD 3029 8" @ 189  
**Bart 2967** TD 2970 5" @ 2969  
DD 3016 B/2 BOPD DD 3029  
Sd-frac.  
Comp. 25 BOPD

**COMPLETED**



