

KANSAS

Cowley

Sec. 25 Twp. 32 R. 4-E

Well No. 1 Ashmore Farm

H. H. Blair Company

Miscellaneous


_____ Ft. from N. Line

330' Ft. from S. Line

_____ Ft. from E. Line

990' Ft. from W. Line

SE SW SE

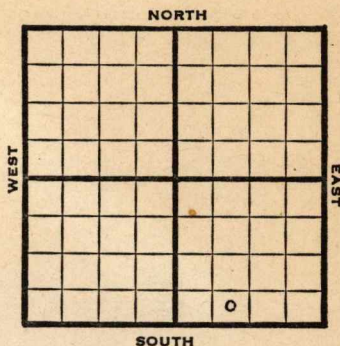

1947

REPORT

10/29

Loc.

11/5

Mach.

11/12

20" @ 10'
Drlg. 740'

11/19

13" @ 910'
Drlg. 1554'

11/25

Drlg. 1830'

12/3

Drlg. 2075'

12/10

5" @ 2141 TD 2143'

12/17

Stal 2140

5" @ 241

Pump 25 oil / 25 wtr Pot

Gravity 38

TD 2143'

COMPLETED

Map No. _____ Sec. 25 Twp. 32 R. 4E

Well No. 1 Ashmore

H. H. Blair Company

FIRST REPORT Contractor

SE SW SE


SECTION PLAT

_____ Ft. from N. Line

330 Ft. from S. Line

_____ Ft. from E. Line

990 Ft. from W. Line

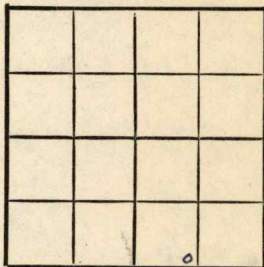

Cowley County

Location X

Rig up _____

Drilling and Remarks:

RECORD

Cased _____ in., _____ ft.

Sand _____

Gas _____

Oil _____

Total Depth _____

PRODUCTION

1st 24 hrs. Nat. _____

1st 24 hrs. after shot _____

Gas _____ Cu. Ft.

Dry Hole _____

Abandoned _____

Date

OCT 29 1947 19

S. J. LEWIS

Scout

Map No. 2 Sec. 25 Twp. 32 R. 4E

Well No. 1 Ashmore

H. H. Blair Company

COMPLETE Contractor

SE SW SE

E 11243

SECTION PLAT

_____ Ft. from N. Line

330 Ft. from S. Line

_____ Ft. from E. Line

990 Ft. from W. Line

Cowley County

Location _____

Rig up _____

Drilling and Remarks:

Stal. 2140
5 2141
Run 25' oil +
SW Pt
850 G

RECORD

Cased _____ in., _____ ft.

Sand _____

Gas _____

Oil _____

Total Depth 2143

PRODUCTION

1st 24 hrs. Nat. _____

1st 24 hrs. after shot _____

Gas _____ Cu. Ft.

Dry Hole _____

Abandoned _____

Date

DEC 17 1947 19

S. J. LEWIS Scout