

KANSAS

Form 51-5M-11-38-Palace

O.W.W.O. Barton


Section 17 Township 16 Range 11-W

Well No. 2 E. Oeser

Company Sinclair ~~Prairie~~ OIL & GAS

NORTH

Prusa Pool

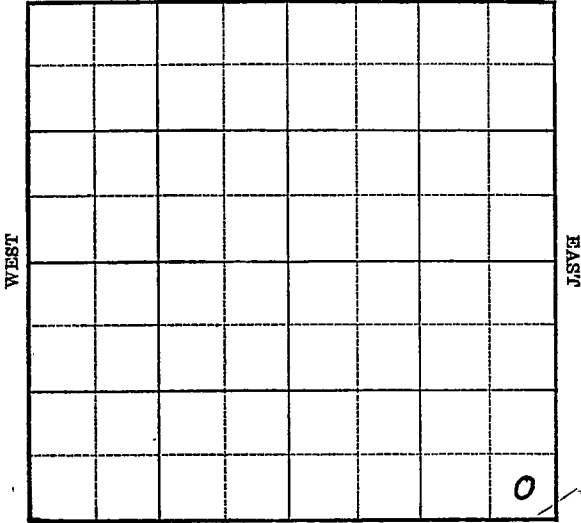

SOUTH

**KANSAS** - Barton  
**O.W.W.O.**

Sec. 17 Twp. 16 R. 11-W

Well No. #2 E. Oeser Farm

Sinclair-Prairie OIL & GAS Company


(Prusa)

\_\_\_\_\_ Ft. from N. Line

330 Ft. from S. Line

330 Ft. from E. Line

\_\_\_\_\_ Ft. from W. Line

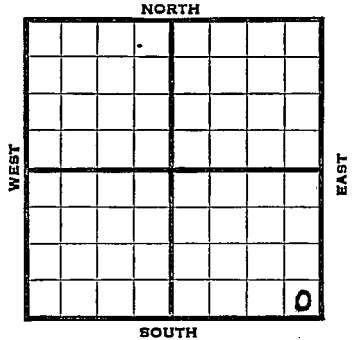

Elev. 1870

1939	REPORT
4/12	Location
4/21	Cellar.
4/28	R. R.
5/5	10" at 105' Drlg. 1470'
5/12	Drlg. 3100'
5/19	Lans. 3000' Slight stain 3160-3170' Cong. 3303' Arb. 3340' S. S. O. and water 3350'
	Drlg. 3426' in quartzite.
5/26	Basal sand 3385' 7" - 3385' T.D. 3426' WOC. Drill stem test shows 1700' water.
5/31	Basal sand 3385'
	Quartzite 3431'
	7" - 3385'
	T.D. 3435'
	2000 acid.
	15 bbls. oil.
	<b>COMPLETED OVER</b>

1954

3/24

KC 3000', Doug 2950',  
 OTD 3426'  
 7" @ 3385'  
 PB 2987'  
 39/ 2950-60 1 bo 1 bw 9 hr.  
 Hydro. P/ 13 BO 24 hr.

3/31

Oil Well  
 TD 3426  
 KC 3000', Doug 2950'  
 OTD 3426'  
 7" @ 3385'  
 PB 2987'  
 39/ 2950-60 1 bo 1 bw 9 hr.  
 Hydro. P/ 13 bo 24 hr.  
 Comp 7 bopd. 5 bw.

**COMPLETED**

Barton

KANSAS

Map No. 55 Sec. 17 Twp. 16 R. 11WWell No. 2 E. OeserSinclair Prairie

Company

Contractor

## FIRST REPORT

SE/C

## SECTION PLAT

			0

\_\_\_\_\_ Ft. from N. Line

330 Ft. from S. Line330 Ft. from E. Line

\_\_\_\_\_ Ft. from W. Line

PRUSA POOL

Location X

Rig up \_\_\_\_\_

Drilling and Remarks:

## RECORD

Cased \_\_\_\_\_ in., \_\_\_\_\_ ft.

Sand \_\_\_\_\_

Gas \_\_\_\_\_

Oil \_\_\_\_\_

Total Depth \_\_\_\_\_

## PRODUCTION

1st 24 hrs. Nat. \_\_\_\_\_

1st 24 hrs. after shot \_\_\_\_\_

Gas \_\_\_\_\_ Cu. Ft.

Dry Hole \_\_\_\_\_

Abandoned \_\_\_\_\_

Date

APR 12 1939 19H. D. Hatfield

Scout

Barton

KANSAS

Map No. 55 Sec. 17 Twp. 16 R. 11W

Well No. 2 E. Oeser

Sinclair Prairie Company

Contractor

COMPLETED

SECTION PLAT

SE/C

\_\_\_\_\_ Ft. from N. Line

330 Ft. from S. Line

330 Ft. from E. Line

\_\_\_\_\_ Ft. from W. Line

PRUSA POOL

			0

Location \_\_\_\_\_

Rig up \_\_\_\_\_

Drilling and Remarks:

*Basal Sand 3385*

*Quartzite 3431*

*7" @ 3385*

*2000 acid*

*15 ft. h.*

RECORD

Cased \_\_\_\_\_ in., \_\_\_\_\_ ft.

Sand \_\_\_\_\_

Gas \_\_\_\_\_

Oil \_\_\_\_\_

Total Depth 3435

PRODUCTION

1st 24 hrs. Nat. \_\_\_\_\_

1st 24 hrs. after shot \_\_\_\_\_

Gas \_\_\_\_\_ Cu. Ft.

Dry Hole \_\_\_\_\_

Abandoned \_\_\_\_\_

Date

MAY 31 1939

19

S. J. LEWIS

Scout



