


Cowley

KANSAS
4E

Section 25 Township 32 Range 4E

Well No. #2 Ashmore

Company H. H. Blair

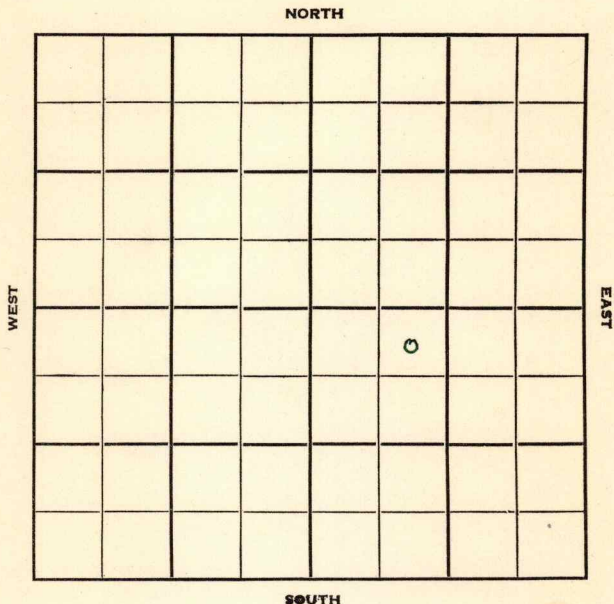

Cowley

KANSAS

Sec. 25 Twp. 32 R. 4E

Well No. # 2 Ashmore Farm

H. H. Blair Company

Lehman Contractor

Tisdale


330 Ft. from N. Line

_____ Ft. from S. Line

_____ Ft. from E. Line

990 Ft. from W. Line

NE NW SE

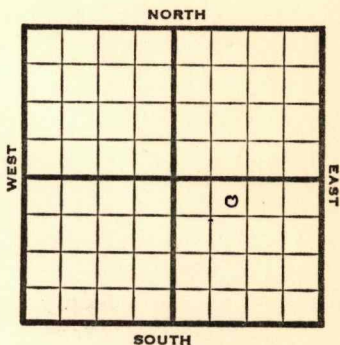

1951

Elev. 1254'

REPORT

11/28

Location

1952

2/6

7" @ 2493

2/13

Drlg. 2825'

3/19

Spud 12-10-51

D & A TD 3118' 15" @ 300

7" @ 2493' Miss 3075' TD 3118'

D & A

ABANDONED

County Cowley State KansasSec. 25 (Blk. 32) (Sur. 4E) Map No.Operator H. H. BlairWell No. 2 Farm AshmoreElev. Location NE NW SE330 Ft. From N Line SE990 Ft. From W Line Quarter1st. Report NOV 28 1951

Completion


Remarks

Lehman - Contr.

Spudding Date

Drig. Data TisdaleLocation

J. E. TYRA

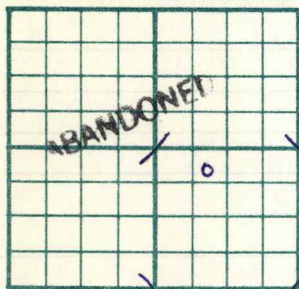County Cowley State KansasSec. 25 (Blk. Twp.) 32 (Sur. Rge.) 4E Map No.Operator H. H. BlairWell No. 2 Farm AshmoreElev. 1254 Location NE NW SE330 Ft. From N Line SE990 Ft. From W Line Quarter

1st. Report

Completion MAR 19 1952Remarks Tisdale PoolLehman - Contr.Spudding Date 12-10-51Drlg. Data D & A TD 311815" @ 300 7" @ 2493 Miss. 3075TD 3118D & A

J. G. McGEHEE