


Section 17 Township 16 Range 11W

Well No. #6 M. Oeser

Company Sinclair Oil & Gas

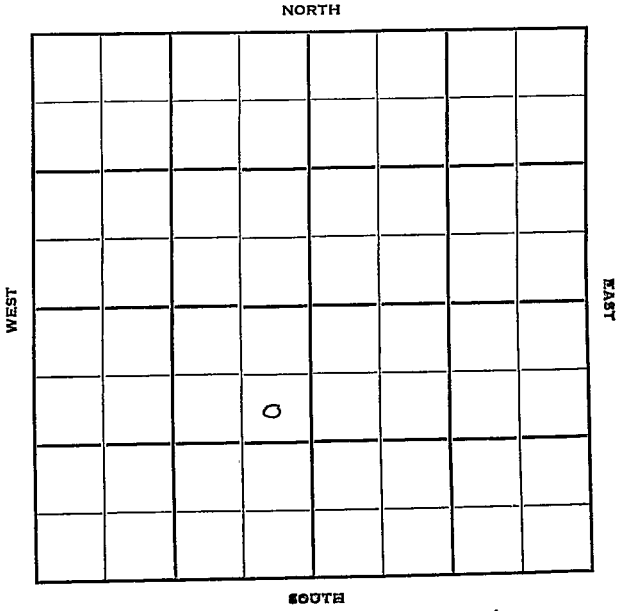

Barton

KANSAS

Sec. 17 Twp. 16 R. 11 W

Well No. # 6 M. Oeser Farm

Sinclair Oil & Gas Company

Mallonee Contractor

Kraft-Prusa Pool


990 Ft. from N. Line

\_\_\_\_\_ Ft. from S. Line

330 Ft. from E. Line

\_\_\_\_\_ Ft. from W. Line

SE NE SW

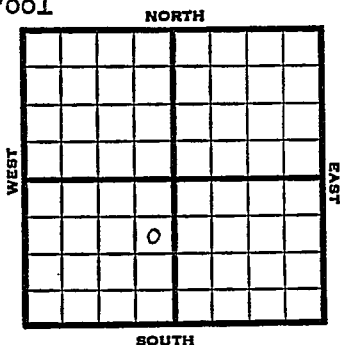

1951 Elev. 1869' REPORT

8/15 Location  
10/3 Spud 8-28-51 Oil well  
TD 3288' 10" @ 288  
Top. 2645' Heeb 2881' Tor. 2986'  
Doug. 2917' Br. lime 2971'  
Lans. 2997' Cong. 3276' Qtz. 3277'  
TD 3288' 5" @ 3278' GO to 3255'  
12/3241-52' 12/3208-21 3/3219-21  
9/3208-12 1000 A S/1 BOPH  
SP 3161' 24/3141-51 1000 A  
F/35 BOPH F/93 BO 7 hr. went dead  
S/55 BOPH 5 hr.  
Comp. 194 BOPD

**COMPLETED**

County Barton State Kansas

Sec. 17 (<sup>Blk.</sup><sub>Twp.</sub>) 16 (<sup>Sur.</sup><sub>Rge.</sub>) 11W Map No.

Operator Sinclair Oil & Gas

Well No. 6 Farm M. Oeser

Elev. Location SE NE SW


990 Ft. From N Line SW

330 Ft. From E Line Quarter

Ist. Report AUG 15 1951

Completion \_\_\_\_\_

Remarks \_\_\_\_\_

Spudding Date \_\_\_\_\_

Drlg. Data Kraft-Prusa Pool

Location

J. E. TYRA

