KANSAS


Form 51—5M—11-38—Palace

Barton

Section 17 Township 16 Range 11-W

Well No. 1 Martha Oeser

Company Sinclair Prairie

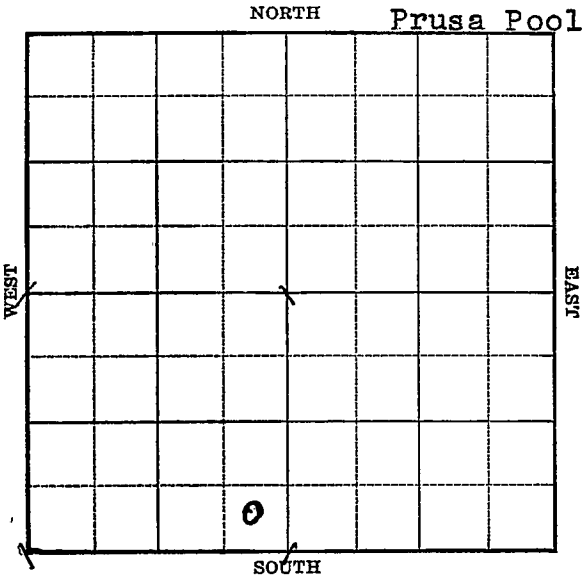

FORM 252-A 5M 10-38 KANSAS Barton

Sec. 17 Twp. 16 R. 11-W

Well No. #1 Martha Oeser Farm

Sinclair-Prairie Company

(Prusa)


____ Ft. from N. Line

440 Ft. from S. Line

440 Ft. from E. Line

____ Ft. from W. Line

Elev. 1880

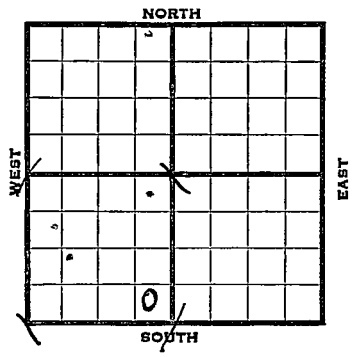

1939	REPORT
2/1	Location
2/10	S. H.
2/17	10" - 100' Anhy 730
	Drlg. 1915'
2/23	Topeka 2645' Lans. 2995'
	Quartzite ~~3255~~ 3253' T.D. 3263'
	No Oil. Will P. B.
3/3	S. O. 3070-3115' & 3135-45 &
	3170-85' Quartzite 3253(Corr)
	7" - 3253' (Cem)
	Perf. 90 shots 3133-42'
	64' oil 6 hrs. 2000 acid.
	Hole cleaned self.
	Est. 50 M gas.
	Rock pressure 950# in 5 hrs.

OVER

1939
3/8 7" - 3253'
Lans. 2995'
Quartzite 3853'
T. D. 3263'
Did not drill out cement plug
after setting casing.
Perf. 3133-42 with 90 shots.
2000 acid.
28½ M cu. ft. gas (Sweet gas)
955# rock pressure.

COMPLETED

Form 26—1M Bks.—2-29

Barton KANSAS

Map No. 55 Sec. 17 Twp. 16 R. 11W

Well No. 1 Martha Oeser

Sinclair Prairie Company

Contractor

FIRST REPORT

SE SW

_____ Ft. from N. Line


440 Ft. from S. Line

440 Ft. from E. Line

_____ Ft. from W. Line

PRUSA POOL

SECTION PLAT

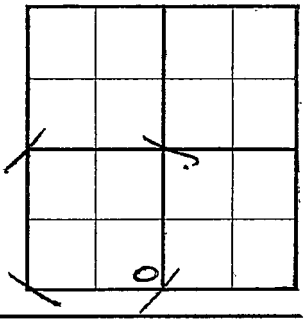

Location X

Rig up

Drilling and Remarks:

RECORD

Cased _____ in., _____ ft.

Sand

Gas

Oil

Total Depth

PRODUCTION

1st 24 hrs. Nat.

1st 24 hrs. after shot

Gas 1 Cu. Ft.

Dry Hole

Abandoned

Date

FEB 1 - 1939 19

H. D. Hatfield Scout

Form 26—1M Bks.—2-29

KANSAS

Barton

Map No. 55 Sec. 17 Twp. 16 R. 11W


Well No. 1 Martha Oeser

Sinclair Prairie Company

Contractor

COMPLETED
SE SW

SECTION PLAT

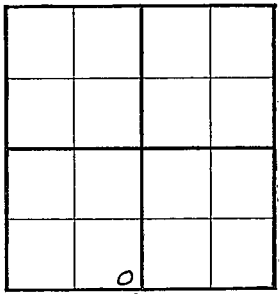

____ Ft. from N. Line

440 Ft. from S. Line

440 Ft. from E. Line

____ Ft. from W. Line

PRUSA POOL

Location

Rig up

Drilling and Remarks:

Did NOT Drill out cement Plug AFTer setting csg.

Per F 3133-42 with 90 shots 2000 Acid 28½ M. gas (Sweet Gas)

955 # R.P.

RECORD

Cased 7 in., 3253 ft.

Sand LANS 2995

~~Gas~~ Quartzite 3253

Oil

Total Depth 3263

PRODUCTION

1st 24 hrs. Nat.

1st 24 hrs. after shot

Gas Cu. Ft.

Dry Hole

Abandoned

Date

MAR 8 - 1939 19

H. D. Hatfield Scout