

DX 78-1


Butler

KANSAS

Section 17 Township 25S Range 5E

Well No. #56 L. W. Robison

Company Texas Company

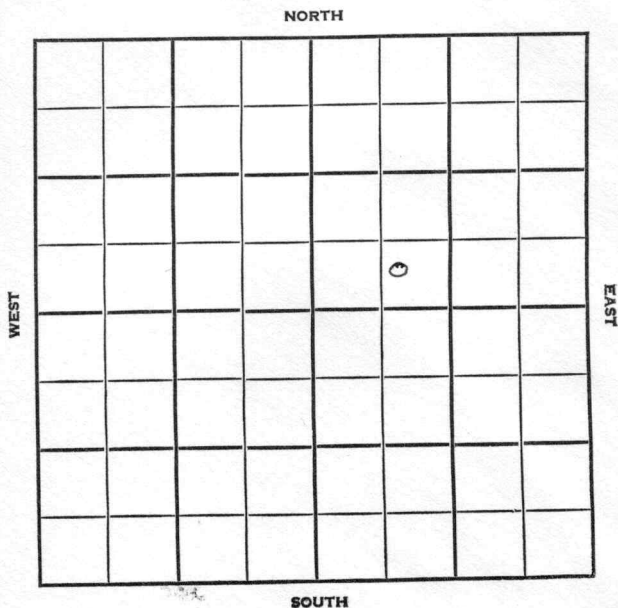

County Butler Elev. _____
 Sec. 17 Twp. 25S Rge. 5E
 Company Texas Company
 Farm Name L. W. Robison No. 56

Co.

TOPS	DEPTH	LOG	DATUM	Loc. in Sec.
Anh.				2260' fnl
Tr.				
H.				3575' fwl
Tr.				
Dg.				
Bl.				
L.				
K.C.				Geol. _____
B.K.C.				Contr. _____
Ce.				
C.				
M.				
M.				Pool _____
K.				
Mz.				<u>ElDorado</u>
Mq.				
V.				
S.				
S.				
A.				
R.				
P.E.				
G.				
T.D.				

Lse.

JUL 28 1956	
FIRST REPORT	

No.

Date Comm. 7/18/56
4 1/2" 700 w/125 Core #1 671-692 - rec.
 20' Core #2 692-712 - rec. 20' WOC

Sec.

T.

R.

1956
 R.G.R.

County Butler Elev. 1367
 Sec. 17 Twp. 25S Rge. 5E
 Company Texas Company
 Farm Name L. W. Robison No. 56

TOPS	DEPTH	LOG	DATUM	Loc. in Sec.
Anh.				2260' fnl
Tp.				
H.				3575' fwl
Tr.				
Dg.				
Bl.				
L.				
K.C.				Geol.
B.K.C.				Contr.
Ce.				
C.				
M.				
M.				
K.				Pool
Mz.				ElDorado
Mo.				
V.				
S.				
S.				
A.				
R.				
PE.				
G.				
T.D.	<u>712</u>			

COMPLETE
 0'
 AUG 8 '56

Date Comm. 7/18/56
4 1/2" 700 w/125 Core #1 671-692 - rec.
20' Core #2 692-712 - rec. 20' WOC
AUG 1 '56 CO 712 + st 1/2 GO + 40
BW 2 hrs Frac. AUG 2 '56 P.
11 B0 + 32 ~~BW~~ BW 16 hrs
(w.o. wts Fld)