

Chautauqua


Map No. Kansas Sec. 33 Twp. 32 R. 10^E

Well No. 2 Wiggam Farm
E. B. Miller Company

NORTH

WEST

EAST

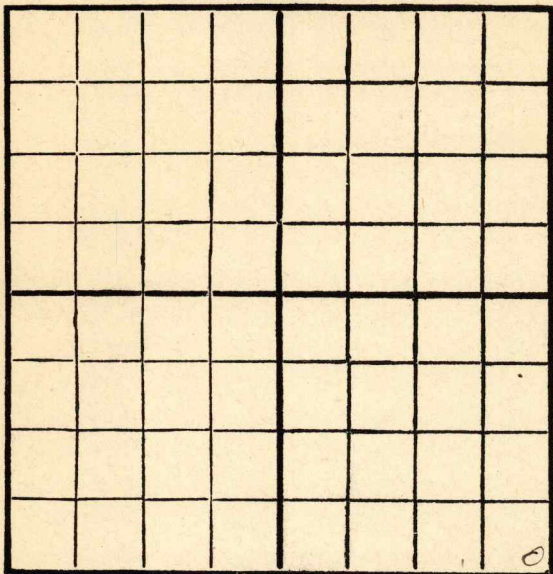

SOUTH

Location _____
Drilling Remarks _____

Rig Up _____
Drilling Remarks _____

RECORD

PRODUCTION


Cased _____ in. _____ ft.
Sand _____
Gas _____
Oil _____
Total Depth _____

1st 24 hrs. Nat. _____
1st 24 hrs. after shot _____
Gas _____ cu. ft. _____
Dry Hole _____
Abandoned _____

Map No. **KANSAS** Sec. 33 Twp. 32 R. 10^E

Well No. 2- Wiggam Farm
C. B. Miller Company

_____ Ft. from N. Line
300 Ft. from S. Line
300 Ft. from E. Line
_____ Ft. from W. Line

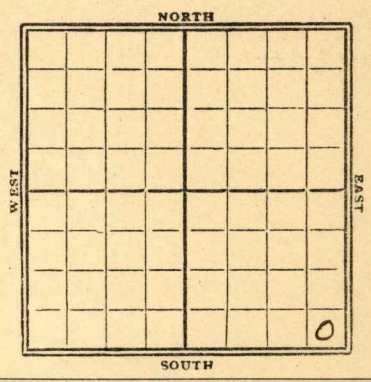

1929

Date

REPORT

Date	REPORT
7/10	Dry 410'
7/17	" 1000'
7/24	" 1540'
7/31	sand 1481-1500'
	shot 60 gts.
	10 bbl oil
	sand 1637-42
	30 bbl oil
	(both sand)
	TD. 1642'
	Pump.

Chautauque

4

Map No. **KANSAS** Sec. 33 Twp. 32 R. 10^E

Well No. E. J. Wiggam
G. B. Miller Company

Contractor

FIRST REPORTS

SECTION PLAT

_____ Ft. from N. Line
300 Ft. from S. Line
300 Ft. from E. Line
_____ Ft. from W. Line

Location _____

RECORD

Rig up _____

Cased _____ in., _____ ft.

Drilling and Remarks:

Sand _____

Og 410

Gas _____

Oil _____

Total Depth _____

PRODUCTION

1st 24 hrs. Nat. _____

1st 24 hrs. after shot _____

Gas _____ Cu. Ft.

Dry Hole _____

Abandoned _____

Date

7/10/29

19

CHAS. L. SHERWOOD

Scout

Chautauque

K4

KANSAS

Map No. _____ Sec. 33 Twp. 32 R. 10

Well No. 2 Wiggam

E. B. Miller

Company

Contractor

COMPLETE

SECTION PLAT

_____ Ft. from N. Line

300 Ft. from S. Line

300 Ft. from E. Line

_____ Ft. from W. Line

Location _____

Rig up _____

Drilling and Remarks:

Sand 1481-1500'
60/10 Bg.

Sand 1637-42

30 Bg both Sand

RECORD

Cased _____ in., _____ ft.

Sand _____

Gas _____

Oil _____

Total Depth 1642

PRODUCTION

1st 24 hrs. Nat. _____

1st 24 hrs. after shot _____

Gas _____ Cu. Ft.

Dry Hole _____

Abandoned _____

Date

JUL 31 1929

CHAS. L. SHERWOOD

19 _____

Scout