FORM 51 5M 10-41 PETROL

KANSAS


Barton

Section 17 Township 16 Range 11 W

Well No. #3 Oser

Company Sinclair-Prairie

(Prusa Pool)

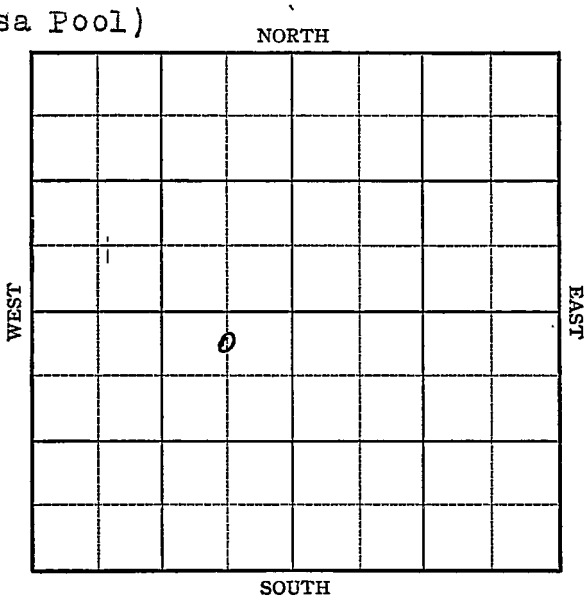

FORM 252-A
5M 10-41 PETROL

KANSAS

Barton

Sec. 17 Twp. 16 R. 11-W

Well No. #3 Oser Farm

Sinclair-Prairie Company

(Prusa)


330 Ft. from N. Line

Ft. from S. Line

660 Ft. from E. Line

Ft. from W. Line

Elev. 1875

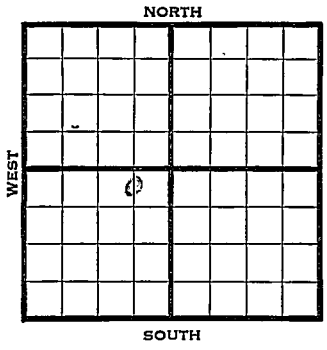

1941	REPORT
12/10	Derrick.
12/18	"
12/24	"
12/31	Surface hole.
1942	
1/8	9" - 167' Drlg. 138.0'
1/15	SD 1400'
1/22	"
1/29	"
2/5	Drlg. 1800'
2/12	Drlg. 3200'
2/19	Topeka 2670' Lans. 3020'
	Cong. 3300' Arb. 3308-12' T.D.
	5" - 3308' 340' oil 2½ hours.

OVER

1942
2/25 Arb. 3308'
5" - 3308'
T.D. 3312'
1500 acid.
Potential 422 bbls., pump.
43.6 Gravity

COMPLETED

Form 26 200 Bks. 5-41 McW. Barton KANSAS

Map No. 57 Sec. 17 Twp. 16 R. 11W

Well No. 3 Oser

Sinclair-Prairie Company

FIRST REPORT Contractor

C NL NE SW

330 Ft. from N. Line


_____ Ft. from S. Line

660 Ft. from E. Line

_____ Ft. from W. Line

PRUSA POOL

SECTION PLAT

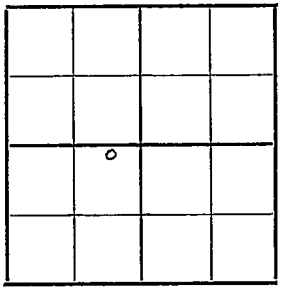

Location _____

Rig up _____

Drilling and Remarks:

Derrick

RECORD

Cased _____ in., _____ ft.

Sand _____

Gas _____

Oil _____

Total Depth _____

PRODUCTION

1st 24 hrs. Nat. _____

1st 24 hrs. after shot _____

Gas _____ Cu. Ft.

Dry Hole _____

Abandoned _____

Date

DEC 10 1941 19

S. J. LEWIS Scout

Form 26 200 Bks. 5-41 McW.

Barton KANSAS

Map No. 55 Sec. 17 Twp. 16 R. 11W

Well No. 3 Oser

Sinclair-Prairie Company

~~COMPLETED~~ Contractor

C NL NE SW

330 Ft. from N. Line


Ft. from S. Line

660 Ft. from E. Line

Ft. from W. Line

PRUSA POOL

SECTION PLAT

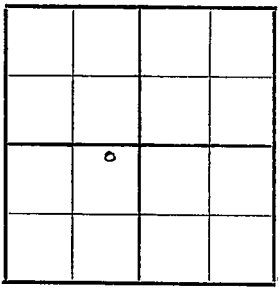

Location

Rig up

Drilling and Remarks:

Cr ✗ 3308.
5" @ 3308.
1500 Rock
Pump #22 P.S.

43 6 Gr

RECORD

Cased in., ft.

Sand

Gas

Oil

Total Depth 3312

PRODUCTION

1st 24 hrs. Nat.

1st 24 hrs. after shot

Gas Cu. Ft.

Dry Hole

Abandoned

Date

FEB 25 1942 19

S. J. LEWIS Scout