


Chautauqua

KANSAS

Section 23 Township 32 Range 10-E

Well Number 1 Schaffer (Shaffer)

Company Mead & Van Benter

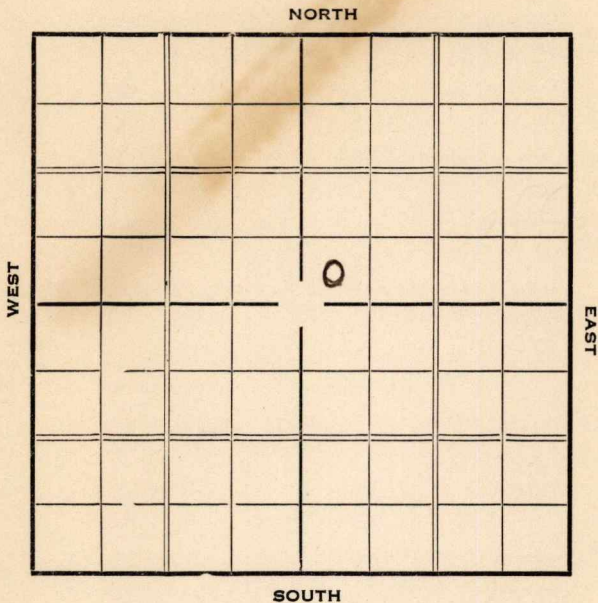

Map No. \_\_\_\_\_ Sec. 23 Twp. 32 R. 10-E

Well No. #1 Schaffer Farm \_\_\_\_\_


\_\_\_\_\_ Mead & Van Benter Company

\_\_\_\_\_ Ft. from N. Line

330 Ft. from S. Line

\_\_\_\_\_ Ft. from E. Line

330 Ft. from W. Line

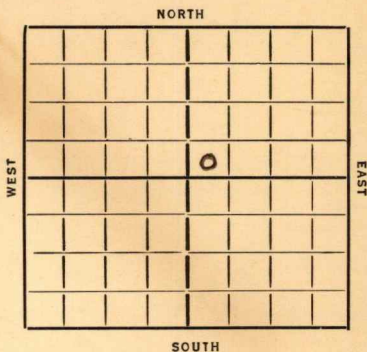

Date	REPORT
<u>1936</u>	
<u>12/16</u>	Location
<u>12/24</u>	" 12/29--
<u>1937</u>	
<u>1/7</u>	Rigging up.
<u>1/14</u>	" "
<u>1/21</u>	Spud.
<u>1/28</u>	Drlg. 640'.
<u>2/4</u>	S. D. 640'.
<u>2/11</u>	Drlg. 695'.
<u>2/18</u>	Drlg. 1070'.
<u>2/26</u>	Drlg. 1580'.
<u>3/3</u>	<b>Mississippi L. 1938'.</b>
	T. D. 1980'.
	Pump 250 bbls.
	<b>COMPLETED</b>

*Chautauqua* **KANSAS**

Map No. 4 Sec. 23 Twp. 32 R. 10E

Well No. 1 Schaffer

Mead & Van Benteb Company

Contractor

**SECTION PLAT**

		8	

\_\_\_\_\_ Ft. from N. Line

330 Ft. from S. Line

\_\_\_\_\_ Ft. from E. Line

330 Ft. from W. Line

**FIRST REPORT**

Location ✓

Rig up \_\_\_\_\_

Drilling and Remarks:

**RECORD**

Cased \_\_\_\_\_ in., \_\_\_\_\_ ft.

Sand \_\_\_\_\_

Gas \_\_\_\_\_

Oil \_\_\_\_\_

Total Depth \_\_\_\_\_

**PRODUCTION**

1st 24 hrs. Nat. \_\_\_\_\_

1st 24 hrs. after shot \_\_\_\_\_

Gas \_\_\_\_\_ Cu. Ft.

Dry Hole \_\_\_\_\_

Abandoned \_\_\_\_\_

Date

DEC 16 1936

19

S. J. LEWIS

Scout

*Chautauque*  
Form 20 1M 3K 2-29

**KANSAS**

Map No. 4 Sec. 23 Twp. 32 R. 10E

Well No. 1 Schaffer

Mead & Van Benter Company

Contractor

**SECTION PLAT**

		0	

\_\_\_\_\_ Ft. from N. Line

330 Ft. from S. Line

\_\_\_\_\_ Ft. from E. Line

330 Ft. from W. Line

COMPLETED

Location \_\_\_\_\_

Rig up \_\_\_\_\_

Drilling and Remarks:

*Mississippi*  
*1988*

*Pump 250 gals*

**RECORD**

Cased \_\_\_\_\_ in., \_\_\_\_\_ ft.

Sand \_\_\_\_\_

Gas \_\_\_\_\_

Oil \_\_\_\_\_

Total Depth 1980

**PRODUCTION**

1st 24 hrs. Nat. \_\_\_\_\_

1st 24 hrs. after shot \_\_\_\_\_

Gas \_\_\_\_\_ Cu. Ft.

Dry Hole \_\_\_\_\_

Abandoned \_\_\_\_\_

Date

MAR 3 1937 19

S. J. LEWIS

Scout