




Section 8 Township 32 Range 11-E

Well Number 2 Kingston


Company Sagmore O&G

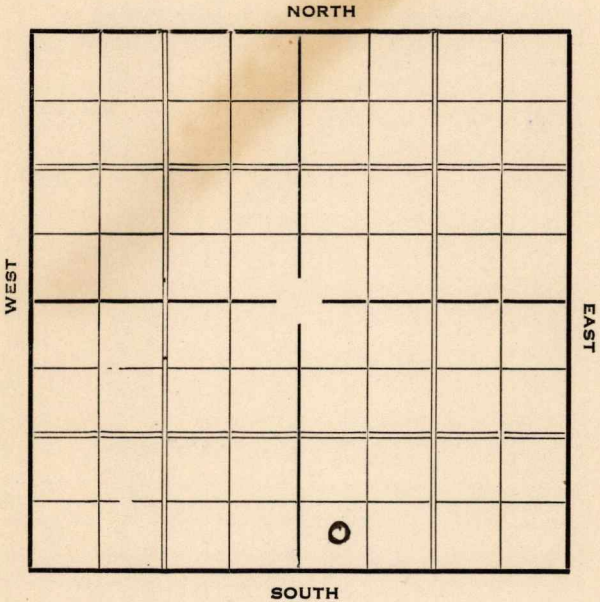

Sec. 8 Twp. 32 R. 11-E

Well No. #2 Kingston Farm
Sagmore O & G Company

 Ft. from N. Line
350 Ft. from S. Line
 Ft. from E. Line
430 Ft. from W. Line

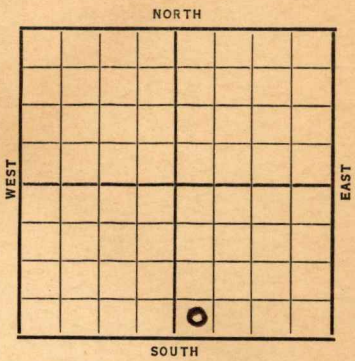

Date	REPORT
1937	
4/14	Mach.
4/23	"
4/30	Drlg. 600'.
5/7	Drlg. 1111'.
5/14	Drlg. 1450'.
5/21	Osw. 1468'. T.D. 1470'.
	Est. 900,000 cu. F. gas.
	Pulling big pipe.
5/28	" " "
6/2	6" @ 1401'.
	Oswald 1468½'.
	T.D. 1471'.
	Pot.
	2 M gas.
	COMPLETED

Chart

KANSAS

Map No. 4 Sec. 8 Twp. 32 R. 11E

Well No. 2-Kingston

Sagamore O. & G. Company

Contractor

COMPLETED

SECTION PLAT

_____ Ft. from N. Line

350 Ft. from S. Line

_____ Ft. from E. Line

430 Ft. from W. Line

		0	

Location _____

Rig up _____

Drilling and Remarks:

Pot

2 M. Gas

RECORD

Cased 6 in., 1401 ft.

Sand Oswald 1468 1/2

Gas _____

Oil _____

Total Depth 1471

PRODUCTION

1st 24 hrs. Nat. _____

1st 24 hrs. after shot _____

Gas _____ Cu. Ft.

Dry Hole _____

Abandoned _____

Date

JUN 2 1931

H. D. Hatfield

Scout

KANSAS @ *Chautauqua*

Map No. 4 Sec. 5 Twp. 22 R. 11E

Well No. 2 Kingston

Sagwell Oil & Gas Company

Contractor

SECTION PLAT

_____ Ft. from N. Line

350 Ft. from S. Line

_____ Ft. from E. Line

430 Ft. from W. Line

		0	

FIRST REPORT

Location _____

Rig up _____

Drilling and Remarks:

Wack

RECORD

Cased _____ in., _____ ft.

Sand _____

Gas _____

Oil _____

Total Depth _____

PRODUCTION

1st 24 hrs. Nat. _____

1st 24 hrs. after shot _____

Gas _____ Cu. Ft.

Dry Hole _____

Abandoned _____

Date

APR 14 1937 19

S. J. LEWIS

Scout