

Butler


KANSAS

SECTION 17 TOWNSHIP 25 RANGE 5E

WELL NO. #58 L.W. Robison

COMPANY The Texas Co.

NORTH

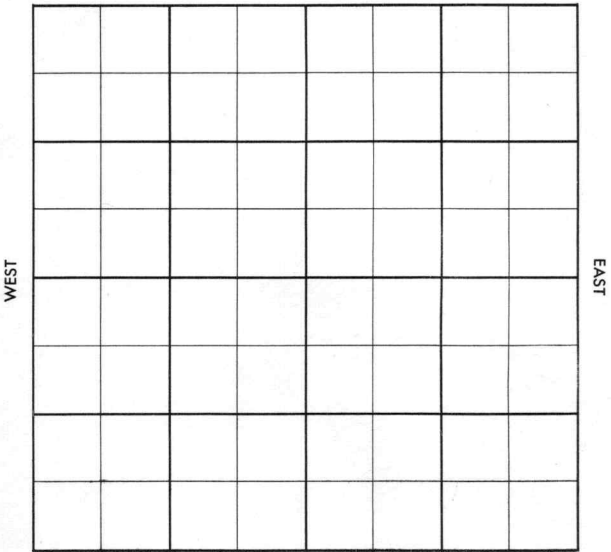

SOUTH

County Butler Elev. _____
 Sec. 17 Twp. 25 Rge. 5E
 Company The Texas Co.
 Farm Name L. W. Robison No. 58

TOPS	DEPTH	LOG	DATUM	Loc. in Sec.
Anh.				
Tp.				
H.				
Tr.				4360' fsl x
Dg.				3030' fel
BL.				twin to #29
L.				Geol.
K.C.				
B.K.C.				Contr.
Ce.				
C.				Shira Drlg.
M.				
M.				Pool
K.				
Mz.				Eldorado
Me.				
V.				
S.				
S.				
A.				
R.				
Pe.				
G.				
T.D.	693			

JUN 6 57
 FIRST REPORT


Date Comm. 5-29-57
 Cored 677-693 rec. 15', set 4" @ 680/125,
 oil sand 679-90

29

Co.
Lse.
No.
Sec.
T.
R.

County Butler Elev. _____
 Sec. 17 Twp. 25 Rgs. 5E
 Company The Texas Co.
 Farm Name L. W. Robison No. 58

TOPS	DEPTH	LOG	DATUM	Loc. in Sec.
Anh.				
Tr.				
Dg.				4360' fsl x
Bl.				3030' fel
L.				twin to #29
K.C.				Geol.
B.K.C.				Contr.
Ce.				
C.				Shira Drlg.
M.				
M.				Pool
K.				ElDorado
Mz.				
Mq.				
V.				
S.				
S.				
A.				
R.				
Pe.				
G.				
T.D.	693			

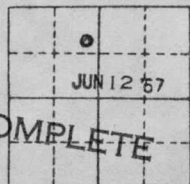

Date Comm. 5-29-57

Cored 677-693 rec. 15', set 4" @ 630/125,
 oil sand 679-90 JUN 12 57 CO 693

P. 17 B0 + 27 BW 12 hrs

P. 45 B0 + 24 BW 24 hrs

Co.

Lse.

No.

Sec.

T.

R.