


Section 18 - Township 25 Range 5E

Well No. 2 Chase

Company Ralph Wixson

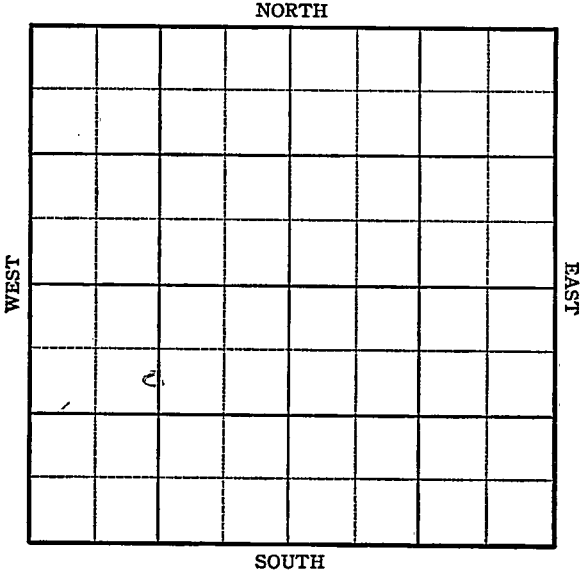

Sec. 18 Twp. 25 R. 5-E


Well No. #2 Chase Farm
Ralph Wixson Company

990 Ft. from N. Line

_____ Ft. from S. Line

_____ Ft. from E. Line

1200 Ft. from W. Line

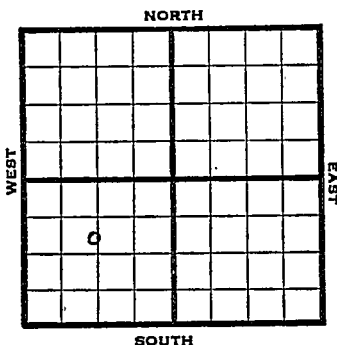

C S L $N\frac{1}{2}$ SW

1945		REPORT
	Elev. 1411	
11/28	Location	
12/5	Mach.	
12/12	15" @ 190 Drlg. 390'	
12/20	12" - 890' Drlg. 1060'	
12/29	Drlg. 1450'	
1946		
1/10	10" - 1600' Lans. 1860' K.C. 2145' 8" - 2235' Drlg. 2425'	
1/17	Miss 2605-13' T.D. 5" - 2607'	
1/23	Miss. 2608 7" @ 2609 TD 2620 Pump 50 Pot. Grav. 38.0	

COMPLETED

KANSAS Kansas Pool Name MiscellaneousMap No. 14 Sec. 18 Twp. 25 R. 5EWell No. 2 ChaseRalph Wixson CompanyFIRST REPORT ContractorC S L N $\frac{1}{2}$ SW990 Ft. from N. Line Ft. from S. Line Ft. from E. Line1200 Ft. from W. Line

SECTION PLAT

		.	
	o		
		.	

Butler County

Location XRig up

Drilling and Remarks:

RECORD

Cased in., ft.Sand Gas Oil Total Depth

PRODUCTION

1st 24 hrs. Nat. 1st 24 hrs. after shot Gas Cu. Ft.Dry Hole Abandoned

Date

NOV 28 1945 19S. J. LEWIS

Scout

KANSAS Kansas Pool Name Miscellaneous

Map No. 14 Sec. 18 Twp. 25 R. 5E

Well No. 2 Chase

Ralph Wixson Company

COMPLETED

Contractor

E11411

SECTION PLAT

C S L $\frac{1}{2}$ SW

990 Ft. from N. Line

_____ Ft. from S. Line

_____ Ft. from E. Line

1200 Ft. from W. Line

Butler County

Location _____

Rig up _____

Drilling and Remarks:

Miss 2605.

7" @ 2605

Pump 50 Pst

38 1/2 G

RECORD

Cased _____ in., _____ ft.

Sand _____

Gas _____

Oil _____

Total Depth 2620

PRODUCTION

1st 24 hrs. Nat. _____

1st 24 hrs. after shot _____

Gas _____ Cu. Ft.

Dry Hole _____

Abandoned _____

Date

JAN 23 1946

19

S. J. LEWIS

Scout