

KANSAS


Form 51-5M-11-38-Palace

Barton

Section 18 Township 16 Range 11-W

Well No. #1 Edward

Company Sinclair Prairie

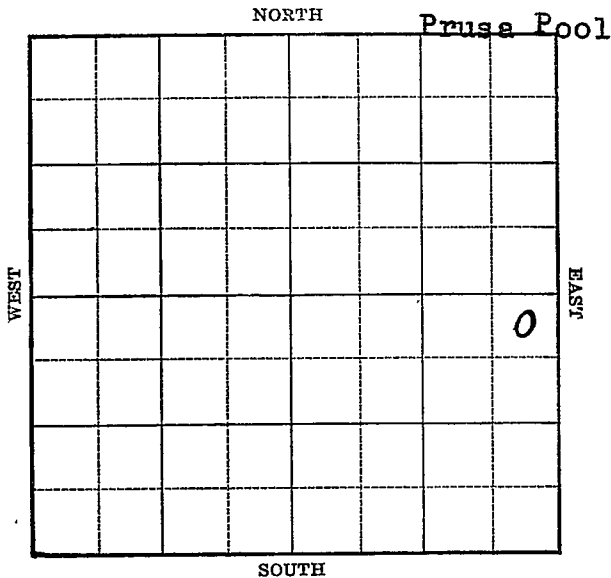

Sec. 18 Twp. 16 R. 11-W

Well No. #1 Edward Farm

Sinclair-Prairie Company

(Prusa)


330 Ft. from N. Line

Ft. from S. Line

330 Ft. from E. Line

Ft. from W. Line

Elev. 1888

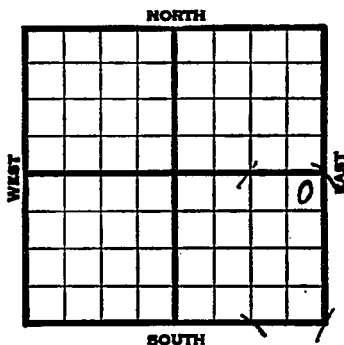

1939	REPORT				
11/8	Rotary.				
11/16	10" - 110'	Drlg.	1900'		
11/23	Arb. 3308'	T.D.	3314'		
	7" - 3309'	RUST.			
11/29	T.D. 3315'	Swab	249 bbls.	5 1/2 hours.	
12/7	" "	" "	" "		
12/14	" "	" "	" "		
12/21	" "	" "	" "		
12/28	" "	" "	" "		
1940					
1/3	Arb. 3308'				
	7" - 3309'				
	T.D. 3315'				
	Echometer potential 1372 bbls.				
	COMPLETED				

Map No. 55 Sec. 18 Twp. 16 R. 11WWell No. 1 EdwardSinclair Prairie

Company

Contractor

COMPLETED**SECTION PLAT**330 NE SE
Ft. from N. Line

Ft. from S. Line

330 Ft. from E. Line

Ft. from W. Line

PRUSA POOL

Location _____

Rig up _____

Drilling and Remarks:

*On 8. 3308**7" @ 3309**Echometer P.V.**1872***RECORD**

Cased _____ in., _____ ft.

Sand _____

Gas _____

Oil _____

Total Depth 3315**PRODUCTION**

1st 24 hrs. Nat. _____

1st 24 hrs. after shot _____

Gas _____ Cu. Ft.

Dry Hole _____

Abandoned _____

Date

Jan 3 19

S. J. LEWIS

Scout