

Barton


Form 51-5M-11-38-Palace

Section 18 Township 16 Range 11-W

Well No. 1 Hoffman

Company Armer & Vernon

NORTH Prusa Pool

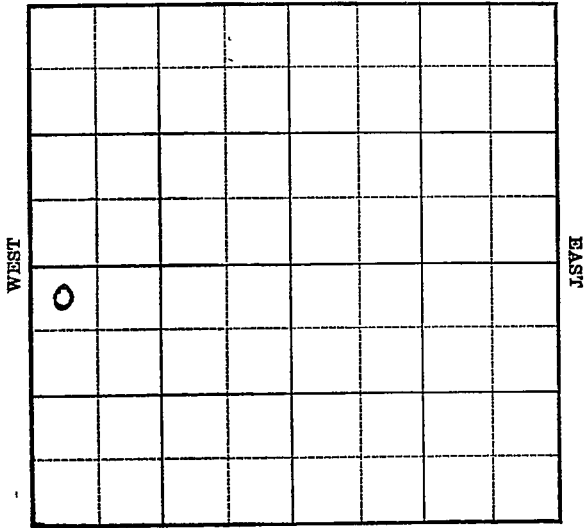

SOUTH

Sec. 18 Twp. 16 R. 11-W

Well No. #1 Hoffman Farm

Armer & Vernon Company


(Prusa)

330 Ft. from N. Line

_____ Ft. from S. Line

_____ Ft. from E. Line

330 Ft. from W. Line

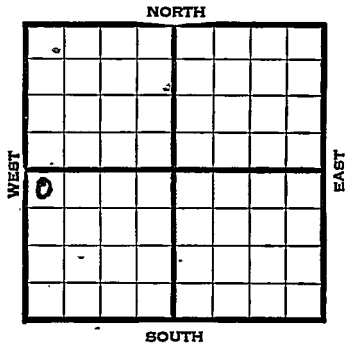

Elev. 1878

1939	REPORT
5/3	Cellar.
	Cable Rig.
5/12	" "
5/19	Spud.
5/26	12" - 317' Drlg. 655'
6/1	10" - 719' Anhy 720'
	Drlg. 1460'
6/8	8" @ 2095' Drlg. 2120'
6/16	2505' U.R. 8".
6/23	8" - 2485' Drlg. 2595'
6/29	Topeka 2625' S. O. 2970-75.
	K. C. 3045' Drlg. 3135'
7/6	7" - 3135' S.O. 3207-75'
	T.D. 3217' 200' oil 8 hrs.
	41. Gravity.
7/13	2000 acid. Swab Est. 10 bbls.
	per hour 8 hrs. 7" cement. 3185'
	WOC.
7/20	T.D. 3217' 1600' oil.
	5000 acid. No test.

OVER

1939
7/26

Lans. 3045'

7" - 3135'

7000 acid.

T.D. 3217'

Pump 527 oil & 99 water for
potential.

COMPLETED

Barton

KANSAS

Map No. 55 Sec. 18 Twp. 16 R. 11WWell No. 1 HoffmanArmer & Vernon Company

Contractor

FIRST REPORT

SECTION PLAT

330 NW SW
Ft. from N. Line

Ft. from S. Line

Ft. from E. Line

330 Ft. from W. Line

0			

PRUSA POOL

Location _____

Rig up _____

Drilling and Remarks:

Cellar
Cable Rig

RECORD

Cased _____ in., _____ ft.

Sand _____

Gas _____

Oil _____

Total Depth _____

PRODUCTION

1st 24 hrs. Nat. _____

1st 24 hrs. after shot _____

Gas _____ Cu. Ft.

Dry Hole _____

Abandoned _____

Date

MAY 3 1939

19

S. J. LEWIS Scout

Map No. 55 Sec. 18 Twp. 16 R. 11W

Well No. 1 Hoffman

Armer & Vernon

Company

Contractor

COMPLETED

NW SW

330 Ft. from N. Line

_____ Ft. from S. Line

_____ Ft. from E. Line

330 Ft. from W. Line

SECTION PLAT

0			

PRUSA POOL

Location _____

Rig up _____

Drilling and Remarks:

*Liams 8045
7" C3135.
7000 acid
Pump 527 oil
99 Water Pit.*

RECORD

Cased _____ in., _____ ft.

Sand _____

Gas _____

Oil _____

Total Depth 8217

PRODUCTION

1st 24 hrs. Nat. _____

1st 24 hrs. after shot _____

Gas _____ Cu. Ft.

Dry Hole _____

Abandoned _____

Date

JUL 26 1939 19

S. J. LEWIS

Scout