

Sec. 18 Twp. 16 R. 11W

Well No. #1 Hoffman Farm

Florney & Williams

Company

Florney

Contractor

Trapp Pool


Ft. from N. Line

990' Ft. from S. Line

Ft. from E. Line

990' Ft. from W. Line

NE SW SW

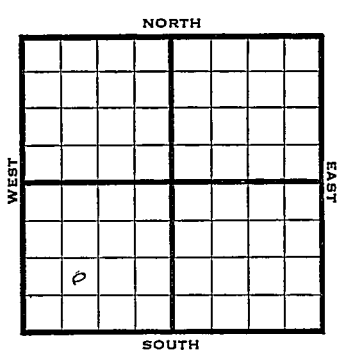

1949. Elev 1894' REPORT

- 10/26 Location
- 11/1 RUR
- 11/9 8" @ 312'
- 11/16 Drlg. 2950'
- Lansing 3056'-
- TD 3328
- 5" @ 3324'
- 2000' oil
- 11/23 TD 3328'
- 11/29 "
- 12/7 TD 3328'
- Lansing 3056'
- 5" @ 3324'
- Pump 100 oil Pot
- 40⁹ Gr.
- Comp

COMPLETED

Map No. _____ Sec. 18 Twp. 16 R. 11W

Well No. 1 Hoffman

Florney & Williams Company

Florney Contractor

NE SW SW

FIRST REPORT
SECTION FLAT

_____ Ft. from N. Line

990 _____ Ft. from S. Line

_____ Ft. from E. Line

990 _____ Ft. from W. Line

Barton County

Location _____ x

Rig up _____

Drilling and Remarks:

RECORD

Cased _____ in., _____ ft.

Sand _____

Gas _____

Oil _____

Total Depth _____

PRODUCTION

1st 24 hrs. Nat. _____

1st 24 hrs. after shot _____

Gas _____ Cu. Ft.

Dry Hole _____

Abandoned _____

Date

OCT 26 1949 19

S. J. LEWIS Scout

Map No. _____ Sec. 18 Twp. 16 R. 11W

Well No. 1 Hoffman "C"

Florney & Williams Company

COMPLETE

Contractor

NE SW SW

E. 1894
SECTION PLAT

_____ Ft. from N. Line

990 Ft. from S. Line

_____ Ft. from E. Line

990 Ft. from W. Line

Barton County

Location _____

Rig up _____

Drilling and Remarks:

None 3056
5" C 3324
Pump 100 oil 100
45 2 20

RECORD

Cased _____ in., _____ ft.

Sand _____

Gas _____

Oil _____

Total Depth *2328*

PRODUCTION

1st 24 hrs. Nat. _____

1st 24 hrs. after shot _____

Gas _____ Cu. Ft.

Dry Hole _____

Abandoned _____

Date

DEC 7 1949 19

S. J. LEWIS Scout