


Section 18 Township 16 Range 11W

Well No. #4 Hoffman "C"

Company N C R A

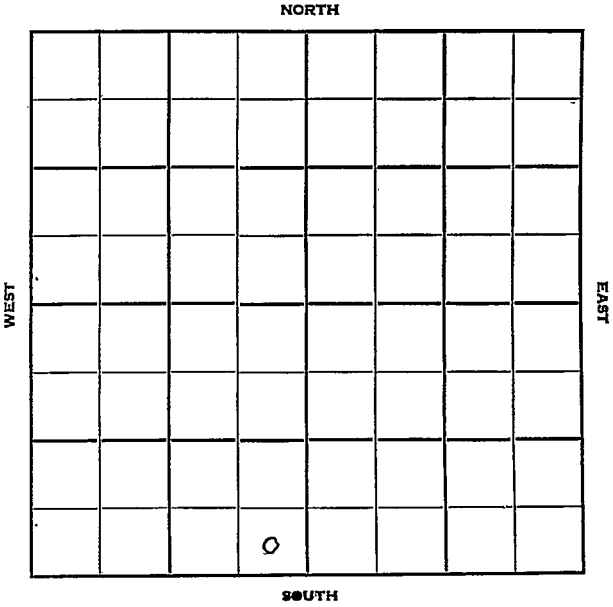


Sec. 18 Twp. 16 R. 11W

Well No. #4 Hoffman "C" Farm

N C R A Company

Flourney & Williams - Contr. Contractor
Kraft-Prusa Pool

Ft. from N. Line
330' Ft. from S. Line
330' Ft. from E. Line
Ft. from W. Line

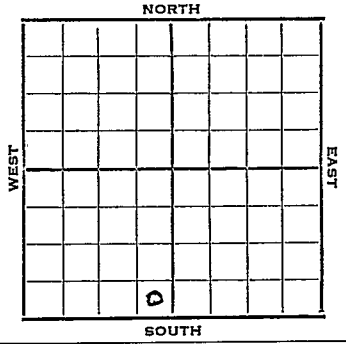

SE SE SW

1951 Elev. 1905' REPORT

12/12 Spud 12-8-51
8-5/8" @ 303

1952
1/2 Spud 12-8-51
D&A TD 3385
8-5/8" @ 303
Heeb. 2966 Tor. 2983
DST 2971-93 open 2 hr. rec. 5' mud
Br. Li 3058 Lans. 3073
DST 3080-3108 open 2 hr.
Rec. 50' mud & SSO
DST 3236-67 open 2 hr.
Rec. 30 SOCM
Arb. 3378
DST 3380-85 open 2 hr.
Rec. 150' mud & SW
D&A

ABANDONED

