

KANSAS


FORM 51 5M 1-42 PETROL

Butler

Section: 18 Township 25 Range 5-E

Well No. #2 Robinson

Company Phil-Han etal

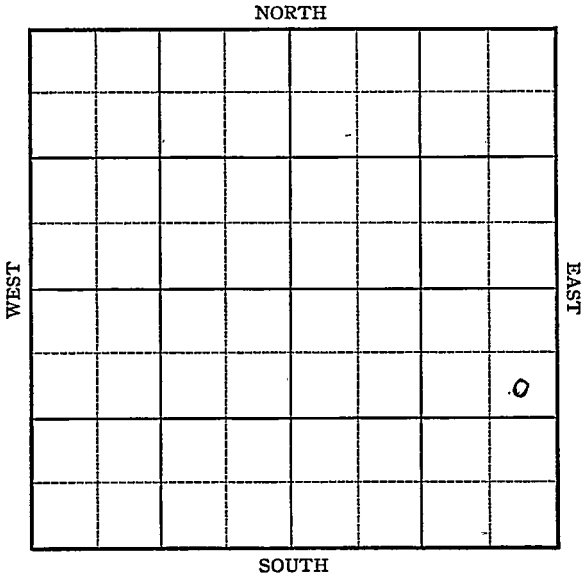


Sec. 18 Twp. 25 R. 5-E

Well No. #2 Robinson Farm

Phil-Han etal Company

NORTH

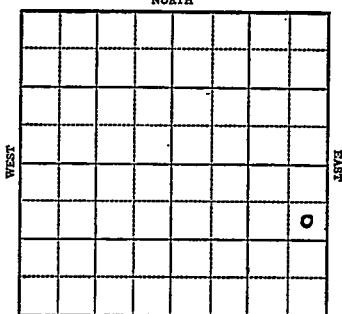

990 Ft. from N. Line

_____ Ft. from S. Line

330 Ft. from E. Line

_____ Ft. from W. Line

SOUTH

1943

R E P O R T

5/5 Location

5/12 Machine

5/19 15" @ 200
Drlg. 640

5/26 Drlg. 1570
12" @ 930'

6/2 10" @ 1678
KC 2125
8" @ 2125
Drlg'. 2490'

6/9 Miss. 2581
6" @2585'
T.D. 2596'
Pump 50 pot.
Gravity 38.4

COMPLETED

Butler

KANSAS Map No. 75 Sec. 18 Twp. 25 R. 5E

Well No. 2 Robinson

Phil-Han et al. Company

FIRST REPORT Contractor

SE NE SE

SECTION PLAT

990 Ft. from N. Line

_____ Ft. from S. Line

330 Ft. from E. Line

_____ Ft. from W. Line

MISCELLANEOUS

Location XX

Rig up _____

Drilling and Remarks:

RECORD

Cased 3 in., _____ ft.

Sand _____

Gas _____

Oil _____

Total Depth _____

PRODUCTION

1st 24 hrs. Nat. _____

1st 24 hrs. after shot _____

Gas _____ Cu. Ft.

Dry Hole _____

Abandoned _____

Date

MAY 5 1943 19

S. J. LEWIS Scout

KANSAS

Butler

Map No. 14 Sec. 18 Twp. 25 R. 5E

Well No. 2 Robinson

Phil-Han etal. Company

COMPLETED

Contractor

SE NE SE

SECTION PLAT

990 Ft. from N. Line

_____ Ft. from S. Line

330 Ft. from E. Line

_____ Ft. from W. Line

			0

MISCELLANEOUS

Location _____

Rig up _____

Drilling and Remarks:

*Wells 2581
6" C 2583
Pump 50 R.S.*

1984

RECORD

Cased _____ in., _____ ft.

Sand _____

Gas _____

Oil _____

Total Depth 2596

PRODUCTION

1st 24 hrs. Nat. _____

1st 24 hrs. after shot _____

Gas _____ Cu. Ft.

Dry Hole _____

Abandoned _____

Date

JUN 9 1943 19

S. J. LEWIS Scout