KANSAS


Barton

Form 51—5M—7-39—Palace O. W. P. B.

Section 18 Township 16 Range 11W

Well No. #1 Krier

Company ~~Black Marshall~~ NC RA

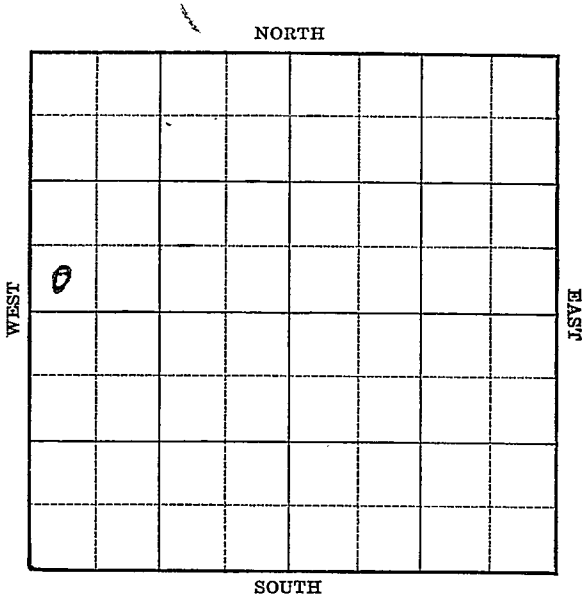

O. W. D. D

FORM 252-A 5M 2-40


KANSAS Barton

Sec. 18 Twp. 16 R. 11-W

Well No. #1 Krier Farm

~~Black Marshall~~ NCRA. Company

(Prusa)

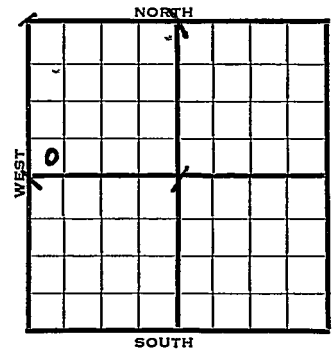

____ Ft. from N. Line

330 Ft. from S. Line

____ Ft. from E. Line

330
~~440~~ Ft. from W. Line

Elev. 1855

	REPORT
~~1940~~	
7/10	Cable rig.
7/18	Rigging up.
7/25	" "
8/2	12½" - 293' Drlg. 590'
8/8	10" - 705' Anhy 705'
	Drlg. 1270'
8/14	8" @ 1832' - Drlg. 1835'
8/22	8" - 2114' Drlg. 2260'
8/29	Topeka 2590' Lans. 3035-45' TD
	Run pipe.
9/5	7" - 3129' SSO 3194-95'
	Drlg. 3230'
9/12	Cong. 3288' Arb. ~~3311~~ 3306'
	T.D. ~~3314~~ 3309' S.O. 5" - ~~3309~~ 3304' WOC.
9/19	Arb. 3306' (Corrected)
	5" - 3304' T.D. 3309'
	1000 acid. Pump 10 bbls. per
	hour.
	OVER

1940
9/25 Arb. 3306'
5" - 3304'
T.D. 3309'
1000 acid.
Dep#hograph potential 2260 bbls.

COMPLETED

O. W. D. D

O. W. D. D

1950

2/1 Arb/ 3303'
OTD 3314'
5"@ 3309'
RUST
Drlg 3406'
2/15 TD 3403'
5"@ 3309'
4" liner @ 3323 input 112 bbls salt w tr. per hr.
Salt wtr disposal
Aband.

ABANDONED

O. W. P. B.

1951
12/22 OTD 3415' 5½" @ 3309' Was SWD well
PB 3251' To perf.

1952
1/2 SWD Well TD 3251
OTD 3415
5½" @ 3309 - PB 3251
16/3264-51 7000 A
Comp. for SWD Well
Abandoned

ABANDONED

Form 26—200 Bks.—1-40—Palace Barton KANSAS

Map No. Sec. 18 Twp. 16 R. 11W

Well No. 1 Krier

Black Marshall Company

Contractor

FIRST REPORT

SW NW

Ft. from N. Line


330 Ft. from S. Line

Ft. from E. Line

440 Ft. from W. Line

Prusa Pool

SECTION PLAT

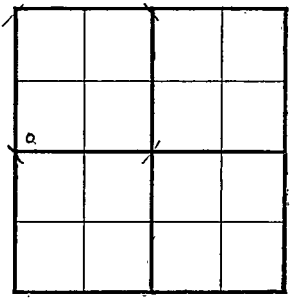

Location

Rig up

Drilling and Remarks:

Cable Rig

RECORD

Cased in., ft.

Sand

Gas

Oil

Total Depth

PRODUCTION

1st 24 hrs. Nat.

1st 24 hrs. after shot

Gas Cu. Ft.

Dry Hole

Abandoned

Date

III 10 1940 19 S. J. LEWIS Scout

Form 26—200 Bks.—1-40—Palace Barton KANSAS

Map No. 55 Sec. 18 Twp. 16 R. 11W

Well No. 1 Krier

Black - Marshall Company

Contractor

COMPLETED

SW NW

_____ Ft. from N. Line


330 Ft. from S. Line

_____ Ft. from E. Line

440 Ft. from W. Line

PRUSA POOL

SECTION PLAT

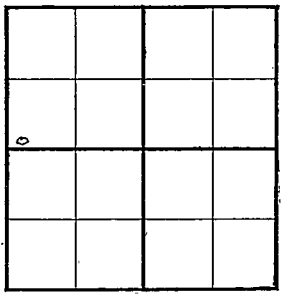

Location _____

Rig up _____

Drilling and Remarks:

Cir Y 3306
5" @ 3304
1000 Acid
Depth PBTD 2260

RECORD

Cased _____ in., _____ ft.

Sand _____

Gas _____

Oil _____

Total Depth 3309

PRODUCTION

1st 24 hrs. Nat. _____

1st 24 hrs. after shot _____

Gas _____ Cu. Ft.

Dry Hole _____

Abandoned _____

Date

SEP 25 1940 19_____ S. J. LEWIS Scout

Form 26 200 Bks. 11-49 Petrol Kansas

Kraft-Prusa Pool

Map No. _____ Sec. 18 Twp. 16 R. 11W

Well No. 1 Krier


N C R A
Company

Contractor

SW SW NW

El. 1855

SECTION PLAT

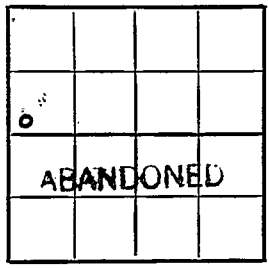

_____ Ft. from N. Line

330 Ft. from S. Line

_____ Ft. from E. Line

330 Ft. from W. Line

OWDO

Barton County

Location _____

Rig up _____

Drilling and Remarks:

5" @ 3309

4" liner @ 3323

input 112 Bbls salt water per hour.

RECORD

Cased _____ in., _____ ft.

Sand _____

Gas _____

Oil _____

Total Depth 3403

PRODUCTION

1st 24 hrs. Nat. _____

1st 24 hrs. after shot _____

Gas _____ Cu. Ft.

Dry Hole _____

Abandoned _____

Salt Water Disposal.

Date

FEB 15 1950

19

J. E. TYRA

Scout

Form 26 200 Bks. 11-49 Petrol

Kansas OWDD

Kraft-Prusa Pool

Map No. ____ Sec. 18 Twp. 16 R. 11W

Well No. 1 Krier


N C R A Company

Contractor

SW SW NW

El. 1855

SECTION PLAT

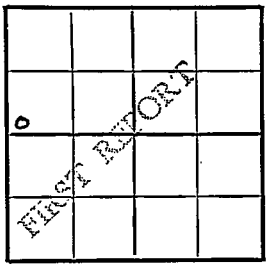

____ Ft. from N. Line

330 Ft. from S. Line

____ Ft. from E. Line

330 Ft. from W. Line

Barton County

Location

Rig up

Drilling and Remarks:

Arb. 3303
OTD 3314
5" @ 3309
RUST
drlg. 3406

RECORD

Cased ____ in., ____ ft.

Sand

Gas

Oil

Total Depth

PRODUCTION

1st 24 hrs. Nat.

1st 24 hrs. after shot

Gas ____ Cu. Ft.

Dry Hole

Abandoned

Date

FEB 1 1950

19 J. F. TYRA Scout

FORM 275 FOR SALE BY KANSAS BLUE PRINT CO.


County Barton State Kansas

Sec. 18 (Blk. / Twp.) 16 (Sur. / Rge.) 11W Map No.

Operator N C R A

Well No. 1 Farm Krier

Elev. 1855 Location SW SW NW

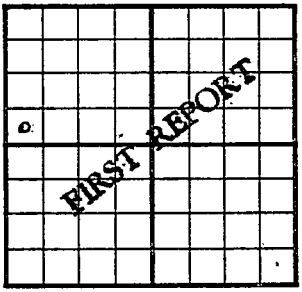

330 Ft. From S Line NW

330 Ft. From W Line Quarter

1st. Report DEC 1 2 1951

Completion O. W. P. B.

Remarks OWPB

Spudding Date

Drlg. Data Kraft-Prusa Pool

OTD 3415 5½" @ 3309 was SWD well

PB 3251 to perf.

J. E. TYRA

FORM 275 FOR SALE BY KANSAS BLUE PRINT CO.


County Barton State Kansas

Sec. 18 (Blk. Twp.) 16 (Sur. Rge.) 11W Map No.

Operator N C R A

Well No. 1 Farm Krier

Elev. 1855 Location SW SW NW

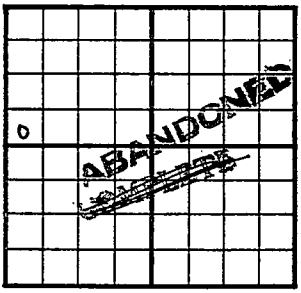

330 Ft. From S Line NW

330 Ft. From W Line Quarter

1st. Report

Completion JAN 2 1952

Remarks OWPB

Spudding Date O. W. P. B.

Drlg. Data SWD well TD 3251

OTD 3415 5½" @ 3309 PB 3251 16/ 3264-51

7000 A Comp. for SWD well

J. E. TYRA