

KANSAS


Butler

FORM 51 5M PETROL

Section 18 Township 25 Range 5-E

Well No. #4 Robinson

Company Adair & Morton

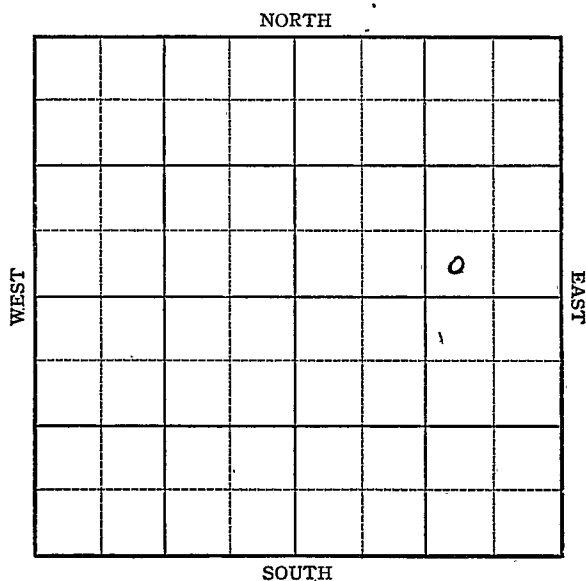


Sec. 17-18 Twp. 25 R. 5-E

Well No. #4 Robinson Farm

Adair & Morton Company

 Ft. from N. Line
330 Ft. from S. Line
990 Ft. from E. Line
 Ft. from W. Line

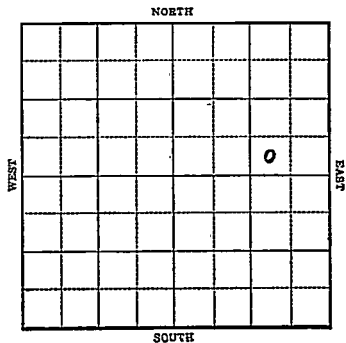

1943

R E P O R T

9/8	Location
9/15	15" @ 245' Drlg. 400'
9/29	10" @ 1760' Drlg. 1955
10/6	" "
10/13	T.D. 2659 Ru 7"
10/20	Viola 2882 No shows T.D. 2907'

ABANDONED

KANSAS

Map No. 14 Sec. 17 Twp. 25 R. 5EWell No. 4 RobinsonAdair & Morton Company

FIRST REPORT Contractor

SW SE NE

_____ Ft. from N. Line

330 Ft. from S. Line990 Ft. from E. Line

_____ Ft. from W. Line

Miscellaneous _____

SECTION PLAT

Location X

Rig up _____

Drilling and Remarks:

RECORD

Cased _____ in., _____ ft.

Sand _____

Gas _____

Oil _____

Total Depth _____

PRODUCTION

1st 24 hrs. Nat. _____

1st 24 hrs. after shot _____

Gas _____ Cu. Ft.

Dry Hole _____

Abandoned _____

Date

SEP 8 1943 19

S. J. LEWIS Scout

KANSAS
 Map No. 17 Sec. 18 Twp. 25 R. 5E

Well No. 4 RobinsonAdair & Morton CompanyCORRECTION Contractor

SW SE NE

SECTION PLAT

 Ft. from N. Line330 Ft. from S. Line990 Ft. from E. Line Ft. from W. Line

			o

MiscellaneousLocation Rig up

Drilling and Remarks:

Reported

17-25-E

RECORD

Cased in., ft.Sand Gas Oil Total Depth

PRODUCTION

1st 24 hrs. Nat. 1st 24 hrs. after shot Gas Cu. Ft.Dry Hole Abandoned

Date

SEP 15 1943

19

S. J. LEWIS

Scout

