


KANSAS

Barton county

Section 18 Township 16 Range 11-W

Well No. #6, Krier

Company Balck-Marshall

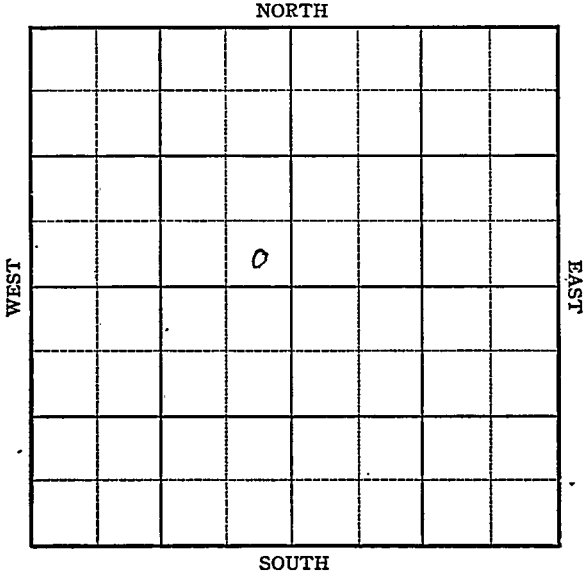

KANSAS

Barton County

Sec. 18 Twp. 16 R. 11W

Well No. #6 Krier Farm

Black-Marshall Company


Kraft-Prusa

Ft. from N. Line

330 Ft. from S. Line

330 Ft. from E. Line

Ft. from W. Line

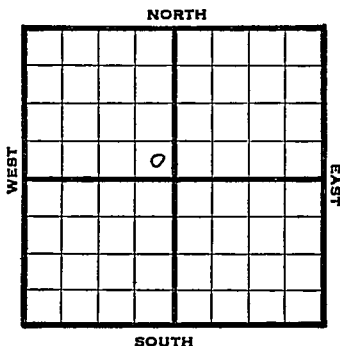

SE NW

1946

1853

REPORT

7/31

RUR

8/6

8" @ 290
Drlg 2378'

8/13

Lans 3010
Arb 3305

TD 3310

5" @ 3305, RUST

8/20

TD 3326 HFW
PB 3250'

8/28

Arb 3305'

5" @ 3305'

TD 3326'

ABANDONED

KANSAS

Kansas

Pool Name Kraft-PrusaMap No. 55 Sec. 18 Twp. 16 R. 11WWell No. 6 KrierBlack-Marshall

Company

FIRST REPORT

Contractor

SE NW

SECTION PLAT

_____ Ft. from N. Line

330 Ft. from S. Line330 Ft. from E. Line

_____ Ft. from W. Line

Barton County,

RECORD

Location _____

Rig up _____

Drilling and Remarks:

R U R

Cased _____ in., _____ ft.

Sand _____

Gas _____

Oil _____

Total Depth _____

PRODUCTION

1st 24 hrs. Nat. _____

1st 24 hrs. after shot _____

Gas _____ Cu. Ft.

Dry Hole _____

Abandoned _____

Date

JUL 31 1946 19S. J. LEWIS

Scout

KANSAS

Kansas

Pool Name Kraft-Prusa PoolMap No. 55 Sec. 18 Twp. 16 R. 11WWell No. 6 KrierBlack-Marshall Company

ABANDONED

Contractor

SE NW

E. I. 183

SECTION PLAT

_____ Ft. from N. Line

330 Ft. from S. Line330 Ft. from E. Line

_____ Ft. from W. Line

Barton County

Location _____

Rig up _____

Drilling and Remarks:

Case 3305
5" @ 3305

RECORD

Cased _____ in., _____ ft.

Sand _____

Gas _____

Oil _____

Total Depth 3326

PRODUCTION

1st 24 hrs. Nat. _____

1st 24 hrs. after shot _____

Gas _____ Cu. Ft.

Dry Hole _____

Abandoned _____

Date

AUG 28 1946 19S. J. LEWIS Scout