

Barton

KANSAS

Section 18 Township 16 Range 11 W


Well No. # 3 Redetzke

Company Brunson Drlg.

NORTH

WEST

EAST

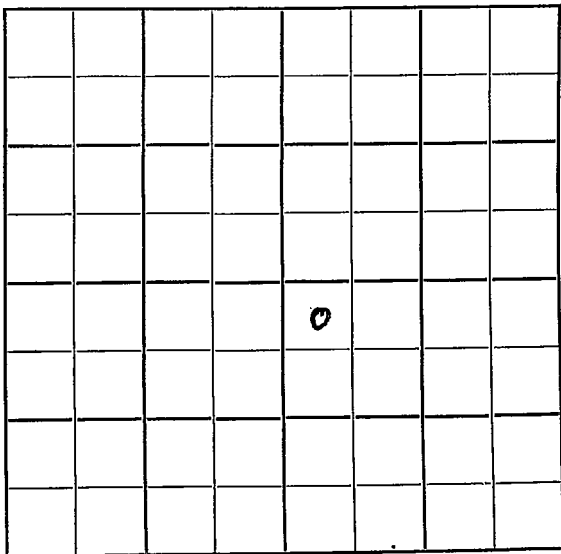

SOUTH

Sec. 18 Twp. 16 R. 11W

Well No. #3 Redetzke Farm

Brunson Drlg. Company

Pom-Kar Contractor


330 Ft. from N. Line

Ft. from S. Line

Ft. from E. Line

330 Ft. from W. Line

NW NW SE

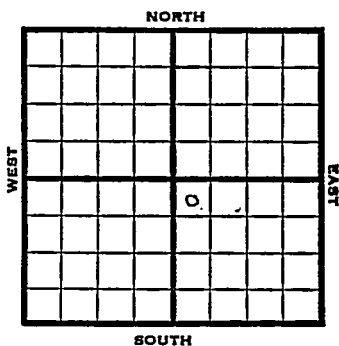

1952 Elev. 1867' REPORT

- 11/18 Spud 11-17-52  
8" @ 324'  
Drlg. 330'
- 11/27 Heeb 2906, Lans 3015,  
Drlg. 3215
- 12/4 ARB 3287-88 RTD 5" @ 3288 DD3289TD  
1500' oil 8 Hrs.
- 12/11 500A DD 3290 TD S/29 BOPH 7 Hrs. POP
- 12/17 Spud 11-17-52  
Oil Well  
TD 3290'  
8" @ 324'  
Heeb 2906, Lans 3015, Arb. 3287  
TD 3288  
5" @ 3288  
DD 3289  
FU 1500' oil 8 hrs., 500A  
DD 3290. S/29 boph  
Comp. 2083 bopd 22% wtr.

**COMPLETED**



