

KANSAS


FORM 51 5M PETROL

Butler

Section 18 Township 25 Range 5E

Well No. #7 Robinson

Company Adair Morton

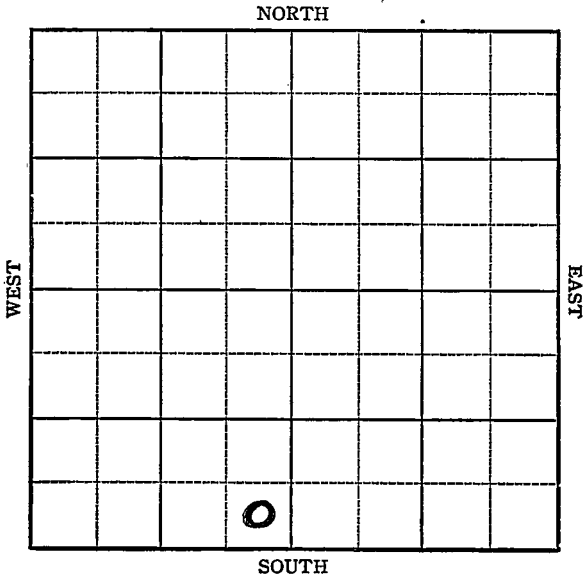

Sec. 18 Twp. 25 R. 5E

Well No. #7 Robinson Farm
Adair Morton Company

Miscellaneous


 Ft. from N. Line

330 Ft. from S. Line

330 Ft. from E. Line

 Ft. from W. Line

Elev. 1391

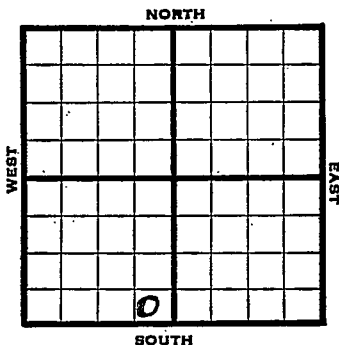

1944 REPORT

4/5	Location
4/12	12" @ 170 Drlg. 765
4/19	10" @ 940 8" @ 1680 Drlg. 1685
4/26	Lans 1820 KC 2105 Miss 2533 Drlg. 2539
5/3	Viola 2765 T ^D 2767

ABANDONED

Map No. 14 Sec. 18 Twp. 25 R. 5E

Well No. 7 Robinson

Adair Morton Company

FIRST REPORT Contractor

SE SW

SECTION PLAT

_____ Ft. from N. Line

330 Ft. from S. Line

330 Ft. from E. Line

_____ Ft. from W. Line

Miscellaneous

Location X

Rig up _____

Drilling and Remarks:

RECORD

Cased _____ in., _____ ft.

Sand _____

Gas _____

Oil _____

Total Depth _____

PRODUCTION

1st 24 hrs. Nat. _____

1st 24 hrs. after shot _____

Gas _____ Cu. Ft.

Dry Hole _____

Abandoned _____

Date

APR 5 1944 19

S. J. LEWIS Scout

KANSAS

Pool Name Miscellaneous

Map No. 14 Sec. 18 Twp. 25 R. 5E

Well No. 7 Robinson

Adair Morton Company

ABANDONED Contractor

SE SW

SECTION PLAT

_____ Ft. from N. Line

330 Ft. from S. Line

330 Ft. from E. Line

_____ Ft. from W. Line

Butler County

RECORD

Location _____

Cased _____ in., _____ ft.

Rig up _____

Sand _____

Drilling and Remarks:

Gas _____

Oil _____

Total Depth 2767

Vid. 2765

PRODUCTION

1st 24 hrs. Nat. _____

1st 24 hrs. after shot _____

Gas _____ Cu. Ft.

Dry Hole _____

Abandoned _____

Date

MAY 3 1944 19

S. J. LEWIS Scout