


Section 18 Township 25 Range 5E

Well No. 12 Robinson

Company Adair & Phil-Han

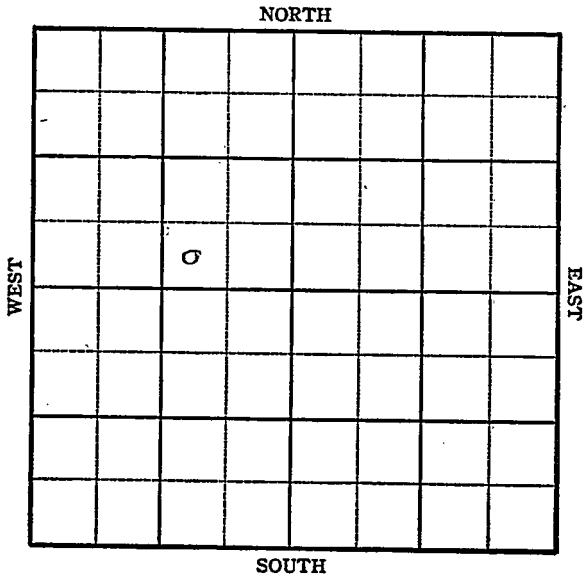

Sec. 18 Twp. 25 R. 5-E


Well No. #12 Robinson Farm
Adair & Phil-Han Company

Ft. from N. Line

990
~~330~~ Ft. from S. Line

660
~~990~~ Ft. from E. Line

Ft. from W. Line

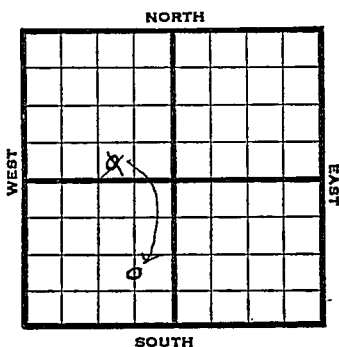

~~SW SE NW~~ C N L SE SW

1945 Elev. 1398' REPORT

11/7 Location

11/14 "

11/21 15" @ 170

Drig. 300'

11/28 Drig. 1135

12" @ 780

12/5 10" @ 1700

Laas 1835

Drig. 1925

12/12 TD 2591

7" @ 2581 WOC

12/20 Chert 2588' T.D. 2610'

Shot 20 qts 2600-10' C O

12/28 Chert 2588

7" @ 2581

20 qts. 2600-2610

TD 2610

Pump 60 Pot.

Grav. 38.0

COMPLETED

KANSAS Pool Name MiscellaneousMap No. 14 Sec. 18 Twp. 25 R. 5EWell No. 12 RobinsonAdair & Phil-Han CompanyFIRST REPORT Contractor

SW SE NW

SECTION PLAT

 Ft. from N. Line330 Ft. from S. Line990 Ft. from E. Line Ft. from W. Line

	o		

Butler CountyLocation XRig up

Drilling and Remarks:

RECORD

Cased in., ft.Sand Gas Oil Total Depth

PRODUCTION

1st 24 hrs. Nat. 1st 24 hrs. after shot Gas Cu. Ft.Dry Hole Abandoned

Date

NOV 7 194519S. J. LEWISScout

KANSAS

Kansas

Pool Name Liscellaneous

Map No. K-14 Sec. 18 Twp. 25 R. 5E

Well No. 12 Robinson

Adair & Phil-Han Company

COMPLETED

Contractor

C N L SE SW

E 11898
SECTION PLAT

 Ft. from N. Line

990 Ft. from S. Line

660 Ft. from E. Line

 Ft. from W. Line

	o		

Butler County

Location _____

Rig up _____

Drilling and Remarks:

*Ok 228 2588.
7" C 2581
259 to 2600-10
Pump 60 ft*

38-1/2

RECORD

Cased _____ in., _____ ft.

Sand _____

Gas _____

Oil _____

Total Depth 2610

PRODUCTION

1st 24 hrs. Nat. _____

1st 24 hrs. after shot _____

Gas _____ Cu. Ft.

Dry Hole _____

Abandoned _____

Date

DEC 28 1945 19

S. J. LEWIS

Scout