


Barton

Section 18 Township 16 Range 11W

Well No. 7 Krier

Company Black-Marshall  
Kraft-Prusa

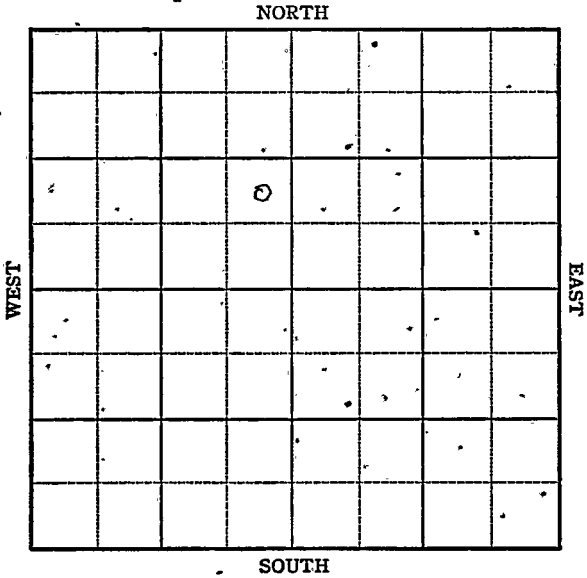


KANSAS Barton ✓

Sec. 18 Twp. 16S R. 11W

Well No. 7 Krier Farm

Black-Marshall Company  
Kraft-Prusa

\_\_\_\_\_ Ft. from N. Line  
990 Ft. from S. Line  
330 Ft. from E. Line  
\_\_\_\_\_ Ft. from W. Line

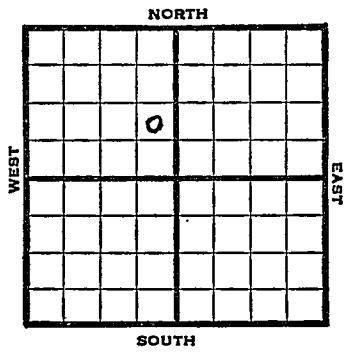

NE SE NW

1947 Elev. 1845 REPORT

3/26 Location  
4/2 RUR  
4/9 8" @ 240'  
Drlg 2860'  
4/15 Lansing 3024'  
Arbuckle 3260'-62' TD  
5" @ 3261'  
RUST  
4/23 " "  
4/29 TD 3265 sw  
swb 86 bbls oil in 5 hrs  
5/7 Arb 3260  
5" @ 3261  
Pump 300 Oil & 17% W  
Grav. 42  
TD 3265'

COMPLETED

Map No. 155 Sec. 18 Twp. 16 R. 11W

Well No. 7 Krier

Black-Marshall Company

FIRST REPORT

Contractor

NE SE NW

SECTION PLAT

\_\_\_\_\_ Ft. from N. Line

990 Ft. from S. Line

330 Ft. from E. Line

\_\_\_\_\_ Ft. from W. Line

	o		

Barton County

Location X

Rig up \_\_\_\_\_

Drilling and Remarks:

RECORD

Cased \_\_\_\_\_ in., \_\_\_\_\_ ft.

Sand \_\_\_\_\_

Gas \_\_\_\_\_

Oil \_\_\_\_\_

Total Depth \_\_\_\_\_

PRODUCTION

1st 24 hrs. Nat. \_\_\_\_\_

1st 24 hrs. after shot \_\_\_\_\_

Gas \_\_\_\_\_ Cu. Ft.

Dry Hole \_\_\_\_\_

Abandoned \_\_\_\_\_

Date

MAR 26 1947 19

S. J. LEWIS Scout

