


Section 18 Township 16 Range 11WWell No. #1 RedetzkeCompany Brunson Drlg.

NORTH

WEST

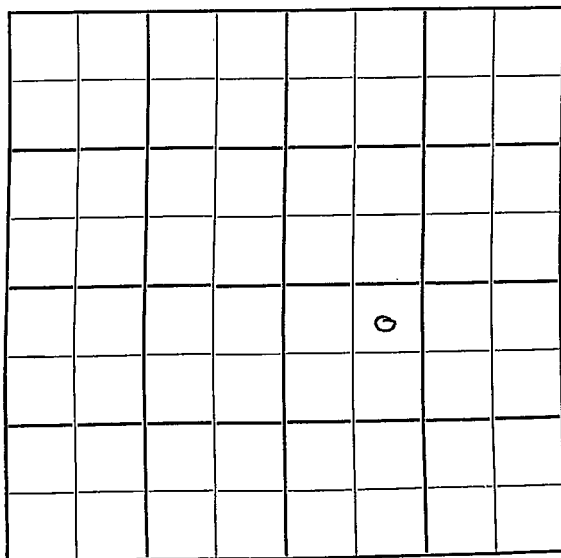

EAST

SOUTH

Barton

KANSAS

Sec. 18 Twp. 16 R. 11W

Well No. #1 Redetzke Farm

Brunson Drlg.

Company

Contractor


330 Ft. from N. Line

Ft. from S. Line

Ft. from E. Line

990 Ft. from W. Line

SE $\frac{1}{4}$ NE NW SE

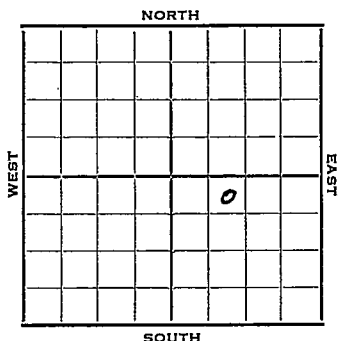

1952

Elev. 1870'

REPORT

10/29

Spud 10-25-52

8" @ 329'

Drlg. 570'

11/5

Heeb. 2907

Tor. 2920

Douglas 2934

Br Li 2798

Lans. 3017

Drlg. 3150'

11/12

Arb. 3283

RTD 3286

5" @ 3284' CO

11/20

CO 3286' Fill up 2700' oil $1\frac{1}{2}$ hrs.
S/80 BOPH 2 hrs. 17' off btm.

11/26

Spud 10-25-52

Oil well TD 3286' 8" @ 329

Anhy 712' Heeb 2907' Tor. 2920'

Doug. 2934' Br. lime 2998'

Lans. 3017' Arb. 3283'

TD 3286' 5" @ 3284' CO to 3286'


FU 2700' oil $1\frac{1}{2}$ hr. S/80 BOPH 2 hr.

Comp. 3000 BOPD

COMPLETED

J. G. McGEHEE

County Barton State Kansas
 Sec. 18 (Blk.) 16 (Sur.) 11W Map No. _____
 Operator Brunson Drlg.
 Well No. 1 Farm Redetzke
 Elev. 1870 Location NE NW SE

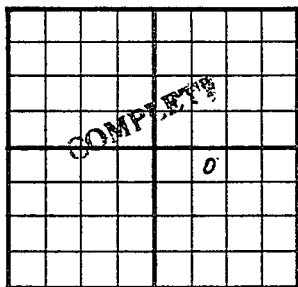

330 Ft. From N Line SE
990 Ft. From W Line Quarter

1st. Report

Completion NOV 26 1952

Remarks

Spudding Date 10-25-52

Drlg. Data Oil well TD 3286

8" @ 329 Anhy 712 Heeb. 2907

Tor. 2920 Doug. 2934 Br. lime 2998

Lans. 3017 Arb. 3283 TD 3286

5" @ 3284 CO to 3286 FTL 27000 oil

1½ hr. S/ 80 boph 2 hr.

Comp. 3000 bopd

J. G. McGEHEE