Barton


FORM 51

KANSAS

Section 18 Township 16 Range 11W

Well No. 7 - Redetzke

Company Brunson Drlg

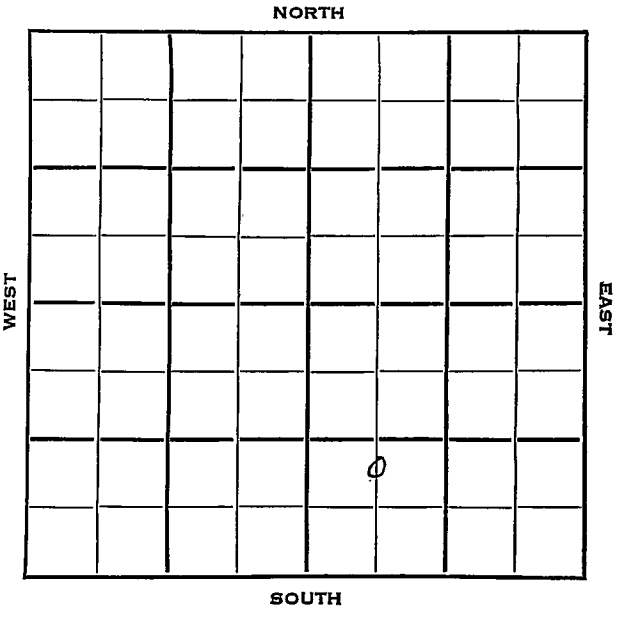

FORM 252-B

KANSAS

Barton

Sec. 18 Twp. 16 R. 11W

Well No. #7 Redetzke Farm

Brunson Drlg. Company

Contractor


Ft. from N. Line

990 Ft. from S. Line

Ft. from E. Line

660 Ft. from W. Line

C N L SW SE

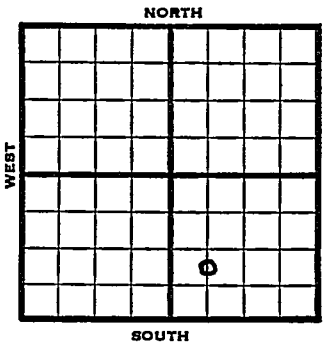

1953	Elev 1885' REPORT
1/21	Spud 1-12-53 8" @ 327 Anhy 721 Drlg. 2885
1/29	Heeb 2940, Tor 2959, B Oread 2969, Br Li 3035, Lans 3055, Cong 3329, Arb. 3355, G. Wash 3436 RTD 3466 7" @ 3400
2/4	Spud 1-12-53 SWD Well TD 3466 8" @ 327 Anhy 721, Heeb 2940, Tor 2959, B. Oread 2969, Br lime 3035, Lans 3055, Cong 3329, Arb 3355, Gr wash 3436 TD 3466 7" @ 3400 CO to 3466 2000A Comp. SWD Well

ABANDONED

FORM 275 FOR SALE BY KANSAS BLUE PRINT CO.

County Barton State Kansas

Sec. 18 (Blk. Twp.) 16 (Sur. Rge.) 11W Map No.

Operator Brunson Drlg.

Well No. 7 Farm Redetzke

Elev. Location C N L SW SE



990 Ft. From S Line SE

660 Ft. From W Line Quarter

1st. Report JAN 21 1953

Completion

Remarks

Spudding Date 1-12-53

Drlg. Data

8" @ 327 Anhy 721 drlg. 2885

J. G. McGEHEE

FORM 275 FOR SALE BY KANSAS BLUE PRINT CO.


County Barton State Kansas

Sec. 18 (Blk. Twp.) 16 (Sur. Rge.) 11W Map No.

Operator Brunson Drlg.

Well No. 7 Farm Redetzke

Elev. 1885 Location C N L SW SE

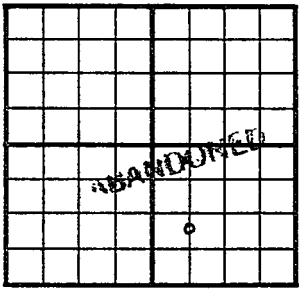

990 Ft. From S Line SE

660 Ft. From W Line Quarter

1st. Report

Completion FEB 4 1953

Remarks

Spudding Date 1-12-53

Drlg. Data SWD well TD 3466

8" @ 327 Anhy 721 Heeb. 2940

Tor. 2959 B. Oread 2969 Br. lime 3035

Lans. 3055 Cong. 3329 Arb. 3355

Gr. wash 3436 TD 3466 7" @ 3400

CO to 3466 2000 A Comp. SWD well

J. G. McGEHEE